UAM UNITED AERIAL MAPPING 5411 JACKWOOD DRIVE · SAN ANTONIO, TEXAS 78238 · (512) 684-2147

DOUGLAS COUNTY,KANSAS Date of photography: 3-29-86 Scale: 1"= 400'

2|1 / 11|12 T 12 S , R 18 E Exp.No.2-12

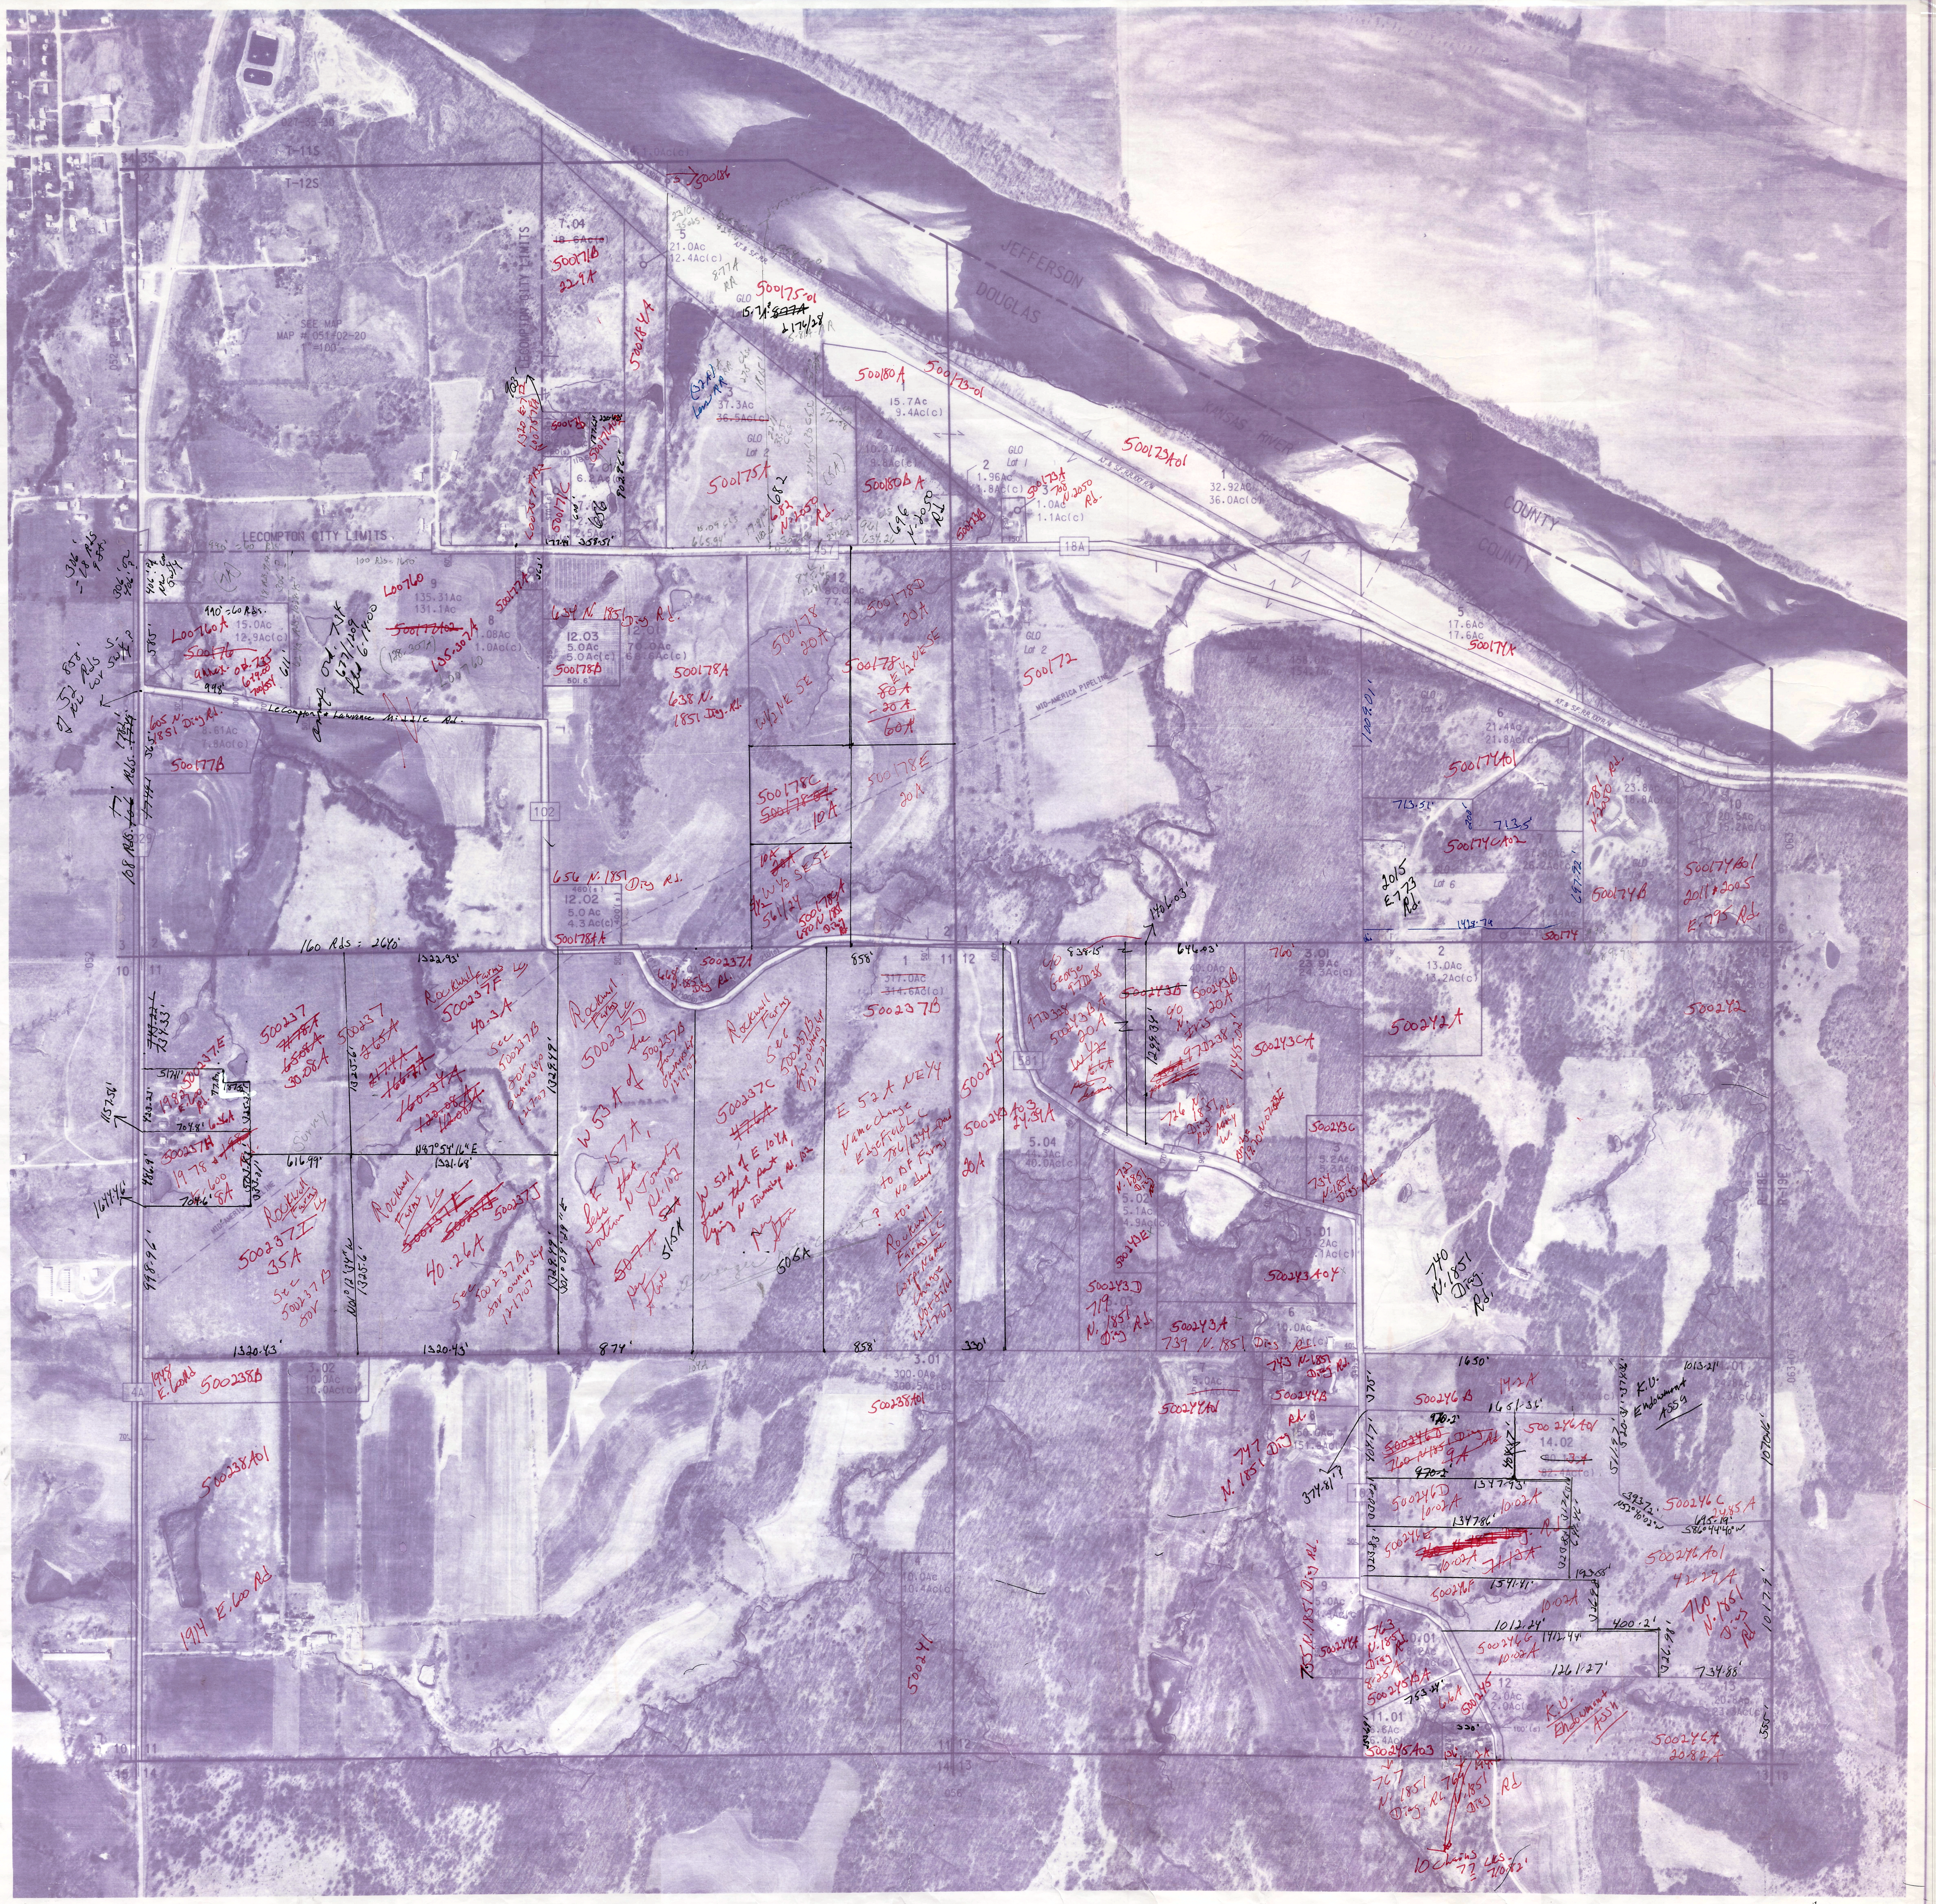

T-11S
T-12S
34 35
3 2
SEE MAP MAP # 051-02-20 1"=100'
052-03
LECOMPTON CITY LIMITS
LECOMPTON CITY LIMITS
306' 18 Rds 9.8s
306' 406'
406' NW cor SW¼
990' =60 Rds.
100 Rds=1650'
L00760A
15.0Ac
12.9Ac(c)
~~500176~~
annex. ord. 735 6-19-00 700/554
9
135.31Ac
131.1Ac
L00760
~~500177A02~~
135.307A
(128.307A)
L00760
8
1.08Ac
1.0Ac(c)
500177A
annex. ord. 735 677/1109 fld 6-14-00
N of 52 Rds S. of NW cor SW¼
858'
585'
998'
611'
Lecompton - Lawrence N. 1/2 C Rd.
605 N. 1851 Diag Rd.
8.61Ac
7.8Ac(c)
500177B
108 Rds.
1781'
365'
329
102
160 Rds = 2640'
7.04
~~18.6Ac(c)~~
500171B
22.9A
500184A
1320 E 7? L00757A
L00757A
500171C
7.01
6.2Ac(c)
656
500171A02
902.86'
177.84
358.51'
5
21.0Ac
12.4Ac(c)
8.77A RR
500175-01
15.71A ~~8.77A~~
2176/28
(32A) Less RR
3
37.3Ac
~~36.5Ac(c)~~
GLO Lot 2
500175A
682 N. 2050 Rd.
665.94'
457
GLO
500180A
500173-01
1
15.7Ac
9.4Ac(c)
2
10.27Ac
9.8Ac(c)
500180B A
696 N. 2050 Rd.
434.26
GLO Lot 1
2
1.96Ac
1.8Ac(c)
500173A
708 N. 2050 Rd.
3
1.0Ac
1.1Ac(c)
500173B
500123A01
JEFFERSON
DOUGLAS
KANSAS RIVER
COUNTY
COUNTY
AT.& SF.RR.100'R/W
1
32.92Ac
36.0Ac(c)
18A
5
17.6Ac
17.6Ac
500174A
634 N. 1851 Diag Rd.
12.03
5.0Ac
5.0Ac(c)
500178B
501.6'
12.01
70.0Ac
68.6Ac(c)
500178A
638 N. 1851 Diag. Rd.
12
80.0Ac
77.4Ac(c)
500178 20A
W½ NE SE
500178D 20A
500178 E½ NE SE ~~80A~~ ~~-20A~~ 60A
500178C ~~500178-01~~ 10A
500178E 20A
10A ~~20A~~ W½ SE SE
E½ 561/24
500178A 680 N. 1851 Diag Rd.
656 N. 1851 Diag Rd.
460(s)
12.02
5.0Ac
4.3Ac(c)
500178AA
GLO Lot 2
500172
MID-AMERICA PIPELINE
GLO Lot 3
158.0Ac
154.7Ac
1009.01'
1406.03'
GLO Lot 4
6
21.4Ac
21.8Ac(c)
500174A01
713.51'
713.5'
500174CA02
GLO Lot 6
2015 E. 773 Rd.
7
27.86Ac
26.2Ac(c)
697.92'
8
1.44Ac
1428.74
500174
781 N. 2050 Rd.
9
23.8Ac
18.8Ac(c)
GLO Lot 5
500174B
10
20.5Ac
15.2Ac(c)
500174B01
2011 & 2005 E. 795 Rd.
063
3
10 11
1322.93'
1329.49'
500237
~~7.78A~~
~~65.08A~~
30.08A
500237
~~76.5A~~
~~217.4A~~
~~166.7A~~
~~160.37A~~
~~120.08A~~
~~112.08A~~
Rockwell Farms LC
500237F
40.3A
See 500237B for ownership 12-17-07
749.22'
737.33'
517.11'
500237E
1982 E. 600 Rd.
77.82
6.36A
704.8'
1157.56'
423.23'
500237H
1978 & ~~1980~~ E. 600 8A
704.6'
1644.46'
486.9'
616.99'
N87°54'16"E
1321.68'
Survey
MID-AMERICA PIPELINE
Rockwell Farms LC
500237I
35A
See 500237B for
998.96'
N01°12'34"W
1325.6'
Rockwell Farms LC
~~500237E~~
~~500237J~~
500237J
40.26A
See 500237B for ownership 12-17-07
1320.43'
1320.43'
1329.49'
S01°09'29"E
Rockwell Farms LC
500237D
W 53A of
See 500237B for Ownership 12-17-07
E 157A, less that portion N Township Rd. 102
~~50.7A~~
51.5A
per Steve
2
668 N. 1851 Diag Rd.
500237I
Rockwell Farms
500237C
~~47.6A~~
See 500237B for ownership 12-17-07
W 52A of E 104A, less that part lying N Township Rd. 102
per Steve
506A
Drainage easement?
874'
104A
858'
1
~~317.0Ac~~
~~314.6Ac(c)~~
500237B
E 52A NE¼
Name change Edgefield LC 786/1344 Deed to DF Farms No deed
Rockwell Farms LC Corp Name Change Not filed 12-17-07
858'
330'
11 12
500243F
500243 A03
24.39A
581
5.04
44.3Ac
40.0Ac(c)
20A
838.15'
646.03'
c/o George 970328
970328
500243BA 20A
W½ 6.6A
~~500243B~~
500243B
c/o Irvis 20A
970238
1299.34'
1445.02'
726 N. 1851 Diag Rd.
1920 N. 1851?
760'
3.01
23.9Ac
24.3Ac(c)
500243CA
2
13.0Ac
13.2Ac(c)
500242A
500242
500243C
3
5.2Ac
5.3Ac(c)
734 N. 1851 Diag Rd.
723 N. 1851 Diag
5.02
5.1Ac
4.9Ac(c)
500243E
500243D
719 N. 1851 Diag Rd.
5.03
5.01
21.2Ac
22.1Ac(c)
500243A04
500243A
739 N. 1851 Diag
6
10.0Ac
740 N. 1851 Diag. Rd.
7
5.0Ac
~~5.1Ac(c)~~
743 N. 1851 Diag Rd.
500244B
500244A01
747 N. 1851 Diag Rd.
8
150.0Ac
151.8Ac(c)
1650'
375'
500246B
14.2A
1651.36'
15
14.2Ac
14.3Ac(c)
970.2'
~~500246D~~
~~760 N. 1851 Diag. Rd.~~
9A
500246A01
14.02
~~80.1~~ ~~3A~~
~~82.4Ac(c)~~
1013.21'
14.01
247.8Ac
24.3Ac(c)
K.U. Endowment Assn
1070.6'
374.81'
1347.93'
500246D
10.02A
1347.86'
500246E
~~760 N. 1851 Diag Rd~~
10.02A
7.13A
323.83'
500246F
1541.41'
10.02A
193.88'
393.72'
500246C
24.85A
695.19'
S86°44'40"W
500246A01
42.29A
760 N. 1861 Diag Rd
1017.9'
1012.24'
400.2'
1412.44'
326.98'
1261.27'
734.88'
755 N. 1851 Diag Rd.
9
5.0Ac
4.4Ac(c)
500244A
763 N. 1851 Diag Rd.
8.25A
500245BA
10.01
8.2Ac
7.7Ac(c)
753.24'
6.6A
500245
12
2.0Ac
2.0Ac(c)
K.U. Endowment Assn
13
20.8Ac
23.3Ac(c)
500246A
20.82A
11.01
5.6Ac
5.4Ac(c)
500245A03
330'
100'(s)
767 N. 1851 Diag. Rd.
764 N. 1851 Diag Rd
10 chains 77 Lks. 710.82'
R-18E
R-19E
063-07
3.02
10.0Ac
10.0Ac(c)
4A
1948 E. 600 Rd
500238B
500238A01
1914 E. 600 Rd
3.01
300.0Ac
300.5Ac(c)
500238A01
500244A01
4
10.0Ac
10.4Ac(c)
500241
10 11
15 14
11 12
14 13
056
12 7
13 18

OWNERSHIP MAP

DOUGLAS COUNTY, KANSAS

PREPARED UNDER THE DIRECTION OF

KANSAS DEPARTMENT OF REVENUE

DIVISION OF PROPERTY VALUATION

AND

BOARD OF COMMISSIONERS

PREPARED BY

DOUGLAS COUNTY

REVISIONS DATE	BY	DATE	BY	DATE	BY	DATE	BY
6/30/89	DRA	6/07/94	SLT				
2/08/91	DRA	7/20/94	DRA				
6/26/91	DRA	8/16/94	DRA				
2/08/93	SLT						

548750

SUBD NO	SUBDIVISION NAME	PLAT BOOK	PLAT PAGE	SUBD CODE

THIS PROPERTY OWNERSHIP MAP IS FOR TAX PURPOSES ONLY. IT IS NOT INTENEDED FOR CONVEYANCES, NOR IS IT A LEGAL SURVEY

LEGEND

TOWNSHIP & RANGE		AREA FROM DEED	10.5 Ac (d)
COUNTY LINE		AREA CALCULATED	10.5 Ac (c)
CORPORATION LINE		DIMENSION FROM DEED	16.5
TAXING UNIT LINE		DIMENSION SCALED	20(s)
R/W LINES		SUBDIVISION LOT NUMBER	23
SECTION LINE		PARCEL NUMBER	10
PROPERTY LINE		WATER	
ORIGINAL LOT LINE		INTERSTATE HIGHWAY	70
LAND HOOK		U.S. HIGHWAY	28
ORIGINAL BLOCK NO	(2)	STATE HIGHWAY	34
ORIGINAL S/D LIMIT	2 1 3	COUNTY ROAD	10
MAP BLOCK NO	"03"	TOWNSHIP ROAD	123
MAP BLOCK LIMIT (WHERE APPLICABLE)	"03" "04"	ROADS, STREETS, CHURCHES, ETC	BY NAME
		SECTION CORNERS	2 1 / 11 12

TOWNSHIP LOCATOR

	03	02	01			
T12S	04	05	06	07	08	
T13S	13	12	11	10	9	
T14S	14	15	16	17	18	
T15 S	23	22	21	20	19	
	R17 E	R18 E	R19 E	R20 E	R21E	

MAP SHEET INDEX

6	5	4	3	2	1
7	8	9	10	11	12
18	17	16	15	14	13
19	20	21	22	23	24
30	29	28	27	26	25
31	32	33	34	35	36

1/4 SECTION INDEX

20	10
30	40

JUL 16 1996

SEC 1,2,11,12 TWP 12S RNG ~~19~~E 18

MAP NO. 051 FEB 16 1996

SCALE 1"=400
DATE OF MAP 11-88
DATE OF PHOTOGRAPHY 3-29-86
AERIAL PHOTO NO. 2-12
PARCEL COUNT 57