UAM UNITED AERIAL MAPPING
5411 JACKWOOD DRIVE · SAN ANTONIO, TEXAS 78238 · (512) 684-2147

DOUGLAS COUNTY, KANSAS Date of photography: 3-29-86 Scale: 1"= 200' Sec. 20 , T 12 S , R 20 E Exp. No. 3-23

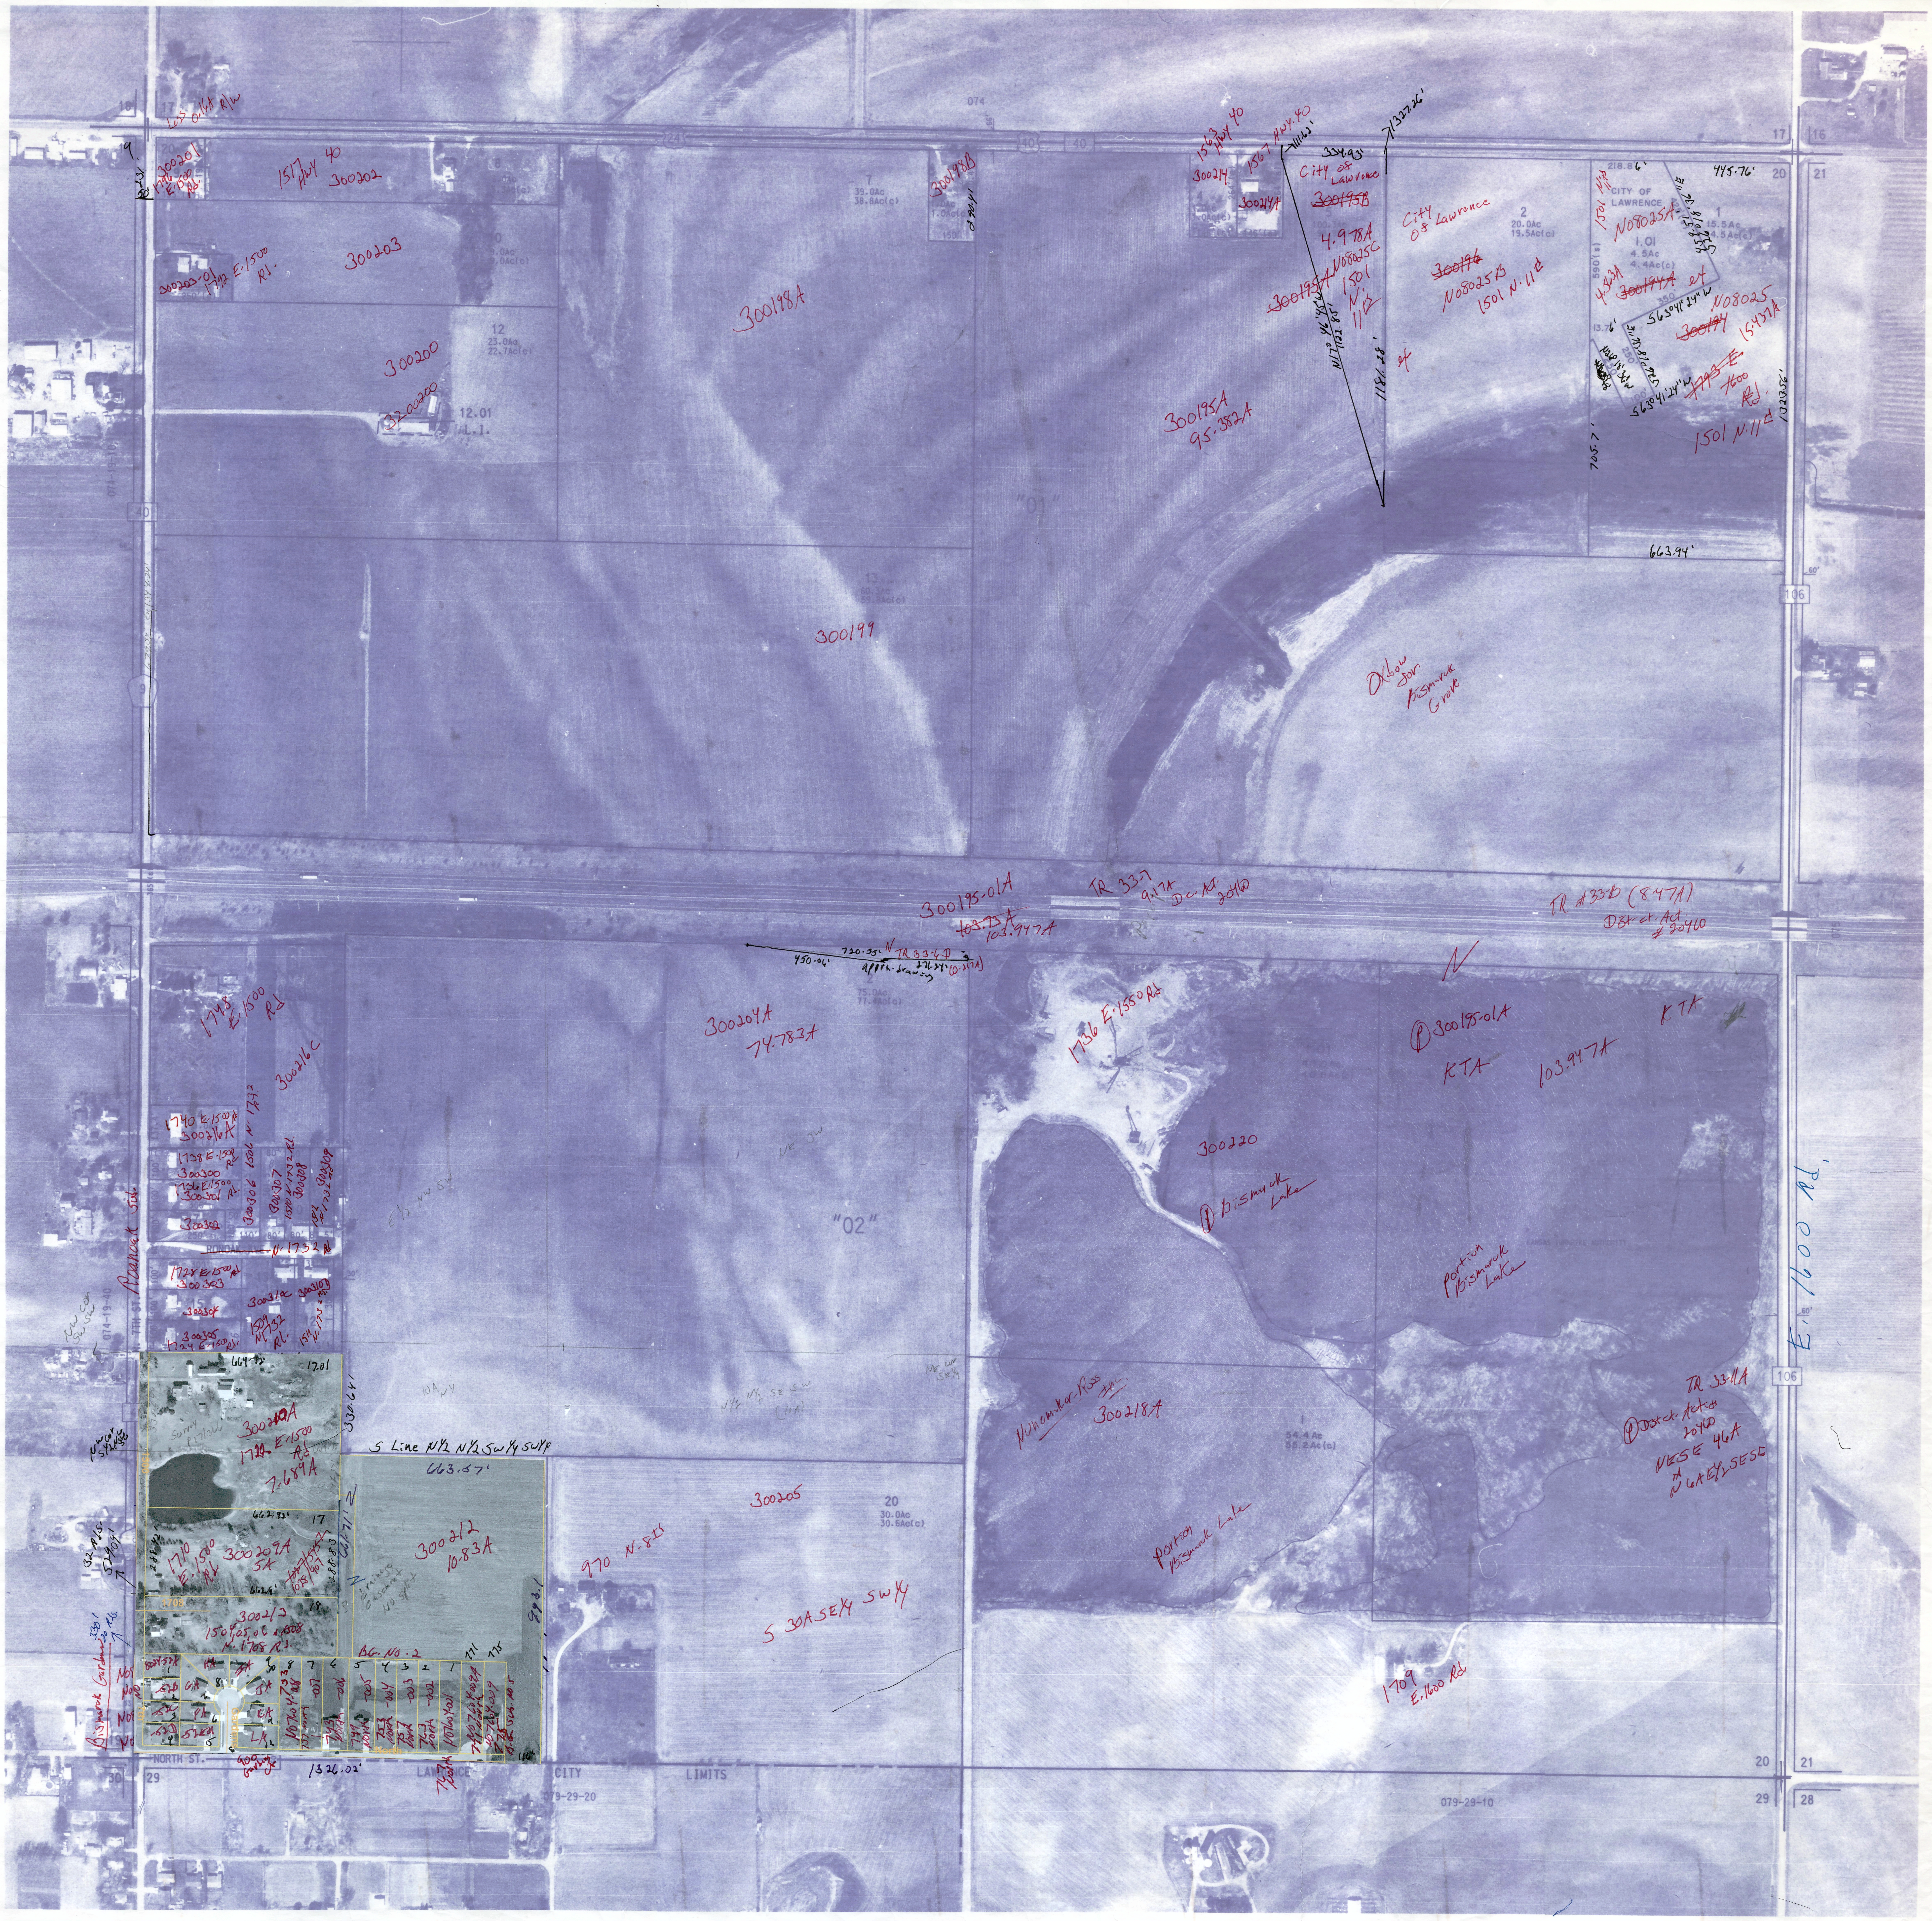

18
17
Loss 0.14A R/W
19
20
300201
1796 E 1500 Rd.
1517 Hwy 40
300202
8
074
24
10
40
7
39.0Ac
38.8Ac(c)
300198B
1.0Ac(c)
150'
290.41
1563 Hwy 40
300214
1567 Hwy 40
300214A
1327.26'
334.93'
111.63'
City of Lawrence
~~300195B~~
4.978A
N08025C
1501 N. 11th
~~300195A~~
N17°46'58"W
1181.28'
City of Lawrence
2
20.0Ac
19.5Ac(c)
~~300196~~
N08025B
1501 N. 11th
218.86'
445.76'
CITY OF LAWRENCE
N08025A
1501 N. 11th
1.01
4.5Ac
4.4Ac(c)
4.43A
~~300194A~~
1
15.5Ac
14.5Ac(c)
590'(s)
350'
S63°41'24"W
N08025
~~300194~~
15.437A
~~1793 E~~ 1600 Rd.
1501 N. 11th
250'
100'
13.76'
1322.56'
705.7'
663.94'
17
16
20
21
10
9.0Ac
9.0Ac(c)
300203
300203-01
1772 E. 1500 Rd.
12
23.0Ac
22.7Ac(c)
300200
300200
12.01
L.I.
300198A
300195A
95.382A
"01"
074-19-10
40
9
13
60.3Ac
59.8Ac(c)
300199
1327.34'
Oxbow for Bismarck Grove
106
60'
300195-01A
~~103.73A~~
103.947A
TR 33-7
9.17A
District Act 20460
TR #33-D (8.47A)
District Act #20460
720.55'
N
TR 33-6-D
450.06'
271.34'
(0.217A)
approx. drawing
2
75.0Ac
77.4Ac(c)
300204A
74.783A
1736 E. 1550 Rd.
N
300195-01A
KTA
103.947A
KTA
1748 E. 1500 Rd
300216C
1740 E. 1500 Rd
300216A
1738 E. 1500 Rd
300300
1736 E. 1500 Rd.
300301
1506 N. 1732 Rd
300302
300306
300307
300308
1510 N. 1732 Rd.
300309
1512 N. 1732 Rd
RONDAK AVE.
N. 1732 Rd
1728 E. 1500 Rd
300303
300304
300305
1724 E. 1500 Rd
300310C
300310D
1509 N. 1732 Rd.
1511 N. 1732 Rd
Roanoak St.
7TH ST.
074-19-40
NW cor SW SW
E½ NW SW
"02"
NE SW
300220
Bismarck Lake
portion Bismarck Lake
KANSAS TURNPIKE AUTHORITY
664.93'
17.01
Survey P17/166
300209A
1722 E. 1500 Rd
7.689A
330.64'
NW cor S½ N½ SW SW
S Line N½ N½ SW¼ SW¼
663.57'
10A NE
N½ N½ SE SW (10A)
NE cor SE¼
662.93'
17
1710 E. 1500 Rd
300209A
5A
288.41'
~~1058~~ 1058
288.83
661.71'
N
drainage easement no split
300212
10.83A
32 R/S 529.01'
1708
662.9'
18
300213
1504, 05, 06 & 1508 N. 1708 Rd.
Bismarck Gardens 330' 20 R/S
BG. No. 2
771
775
993.1'
Nunemaker-Ross Inc.
300218A
1
54.4Ac
55.2Ac(c)
20
30.0Ac
30.6Ac(c)
300205
970 N. 815
S 30A SE¼ SW¼
portion Bismarck Lake
TR 33-11A
District Action 20460
NESE 46A
N 6A E½ SESE
E. 1600 Rd.
106
1709 E. 1600 Rd
North St.
600 Gardens Ct
1326.02'
29
30
LAWRENCE CITY LIMITS
079-29-20
079-29-10
20
21
29
28

OWNERSHIP MAP
DOUGLAS COUNTY, KANSAS
PREPARED UNDER THE DIRECTION OF
KANSAS DEPARTMENT OF REVENUE
DIVISION OF PROPERTY VALUATION
AND
BOARD OF COMMISSIONERS
PREPARED BY
DOUGLAS COUNTY

REVISIONS	DATE	BY	DATE	BY	DATE	BY	DATE	BY
	7/11/89	DRA						
	8/23/94	DRA						

SUBD. NO.	SUBDIVISION NAME	PLAT BOOK	PLAT PAGE	SUBD CODE
1	RONDAK	4	33	1575
2	NORTH LAWRENCE BISMARCK GARDENS	14	66	0122

THIS PROPERTY OWNERSHIP MAP IS FOR TAX PURPOSES ONLY
IT IS NOT INTENEDED FOR CONVEYANCES, NOR IS IT A LEGAL SURVEY

LEGEND

TOWNSHIP & RANGE		AREA FROM DEED	0.5 Ac (d)
COUNTY LINE		AREA CALCULATED	10.5 Ac (c)
CORPORATION LINE		DIMENSION FROM DEED	16.5'
TAXING UNIT LINE		DIMENSION SCALED	20'(s)
R/W LINES		SUBDIVISION LOT NUMBER	23
SECTION LINE		PARCEL NUMBER	10
PROPERTY LINE		WATER	
ORIGINAL LOT LINE		INTERSTATE HIGHWAY	70
LAND HOOK		U.S. HIGHWAY	28
ORIGINAL BLOCK NO.	2	STATE HIGHWAY	34
ORIGINAL S/D LIMIT		COUNTY ROAD	10
MAP BLOCK NO.	"03"	TOWNSHIP ROAD	123
MAP BLOCK LIMIT (WHERE APPLICABLE)	"03" "04"	ROADS, STREETS, CHURCHES, ETC	BY NAME
	2 1 / 11 12	SECTION CORNERS	

TOWNSHIP LOCATOR

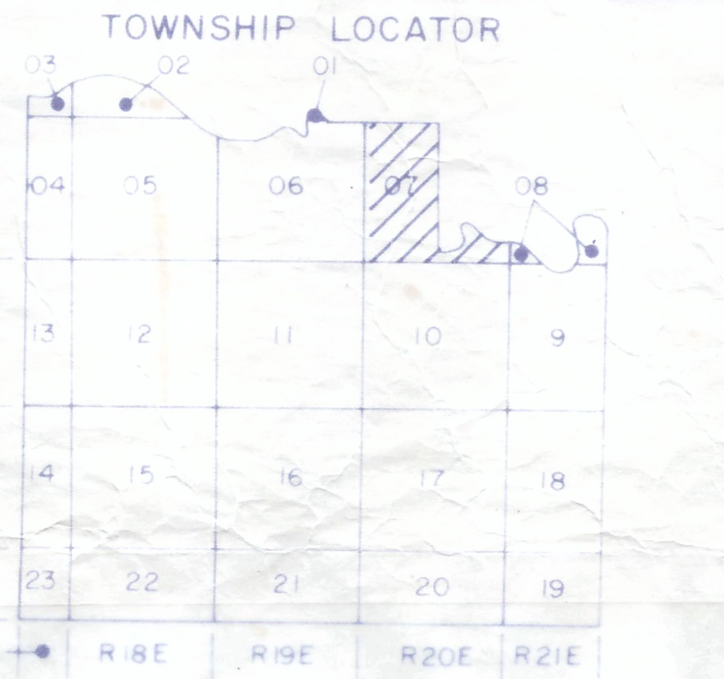

T11S
T12S
T13S
T14S
T15S
03
02
01
04
05
06
07
08
13
12
11
10
9
14
15
16
17
18
23
22
21
20
19
R17E
R18E
R19E
R20E
R21E

MAP SHEET INDEX

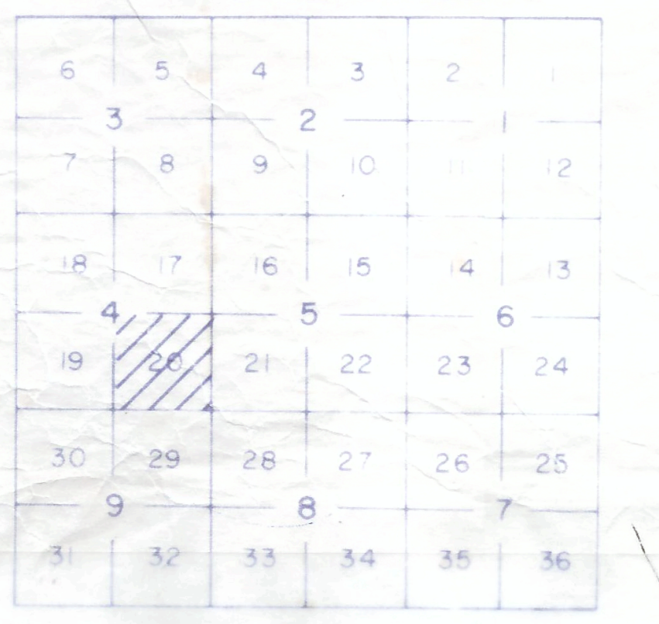

6
5
4
3
2
1
3
2
1
7
8
9
10
11
12
18
17
16
15
14
13
4
5
6
19
20
21
22
23
24
30
29
28
27
26
25
9
8
7
31
32
33
34
35
36

1/4 SECTION INDEX

20	10
30	40

10-26-99
[illegible]

SEC. 20 TWP. 12S RNG. 20E

MAP NO. 074-20

SCALE	1"=200
DATE OF MAP	3-29-86
DATE OF PHOTOGRAPHY	3-27-86
AERIAL PHOTO NO.	3-23
PARCEL COUNT	40

074-20