DOUGLAS COUNTY, KANSAS Date of photography: JANUARY 2000 Scale: 1"=100' SE 1/4 SEC 22 T12S R19E IMAGE: 0652240

MARKHURD

Plots prepared from multiple image sources, resolutions and dates of photography (January and March, 2000)

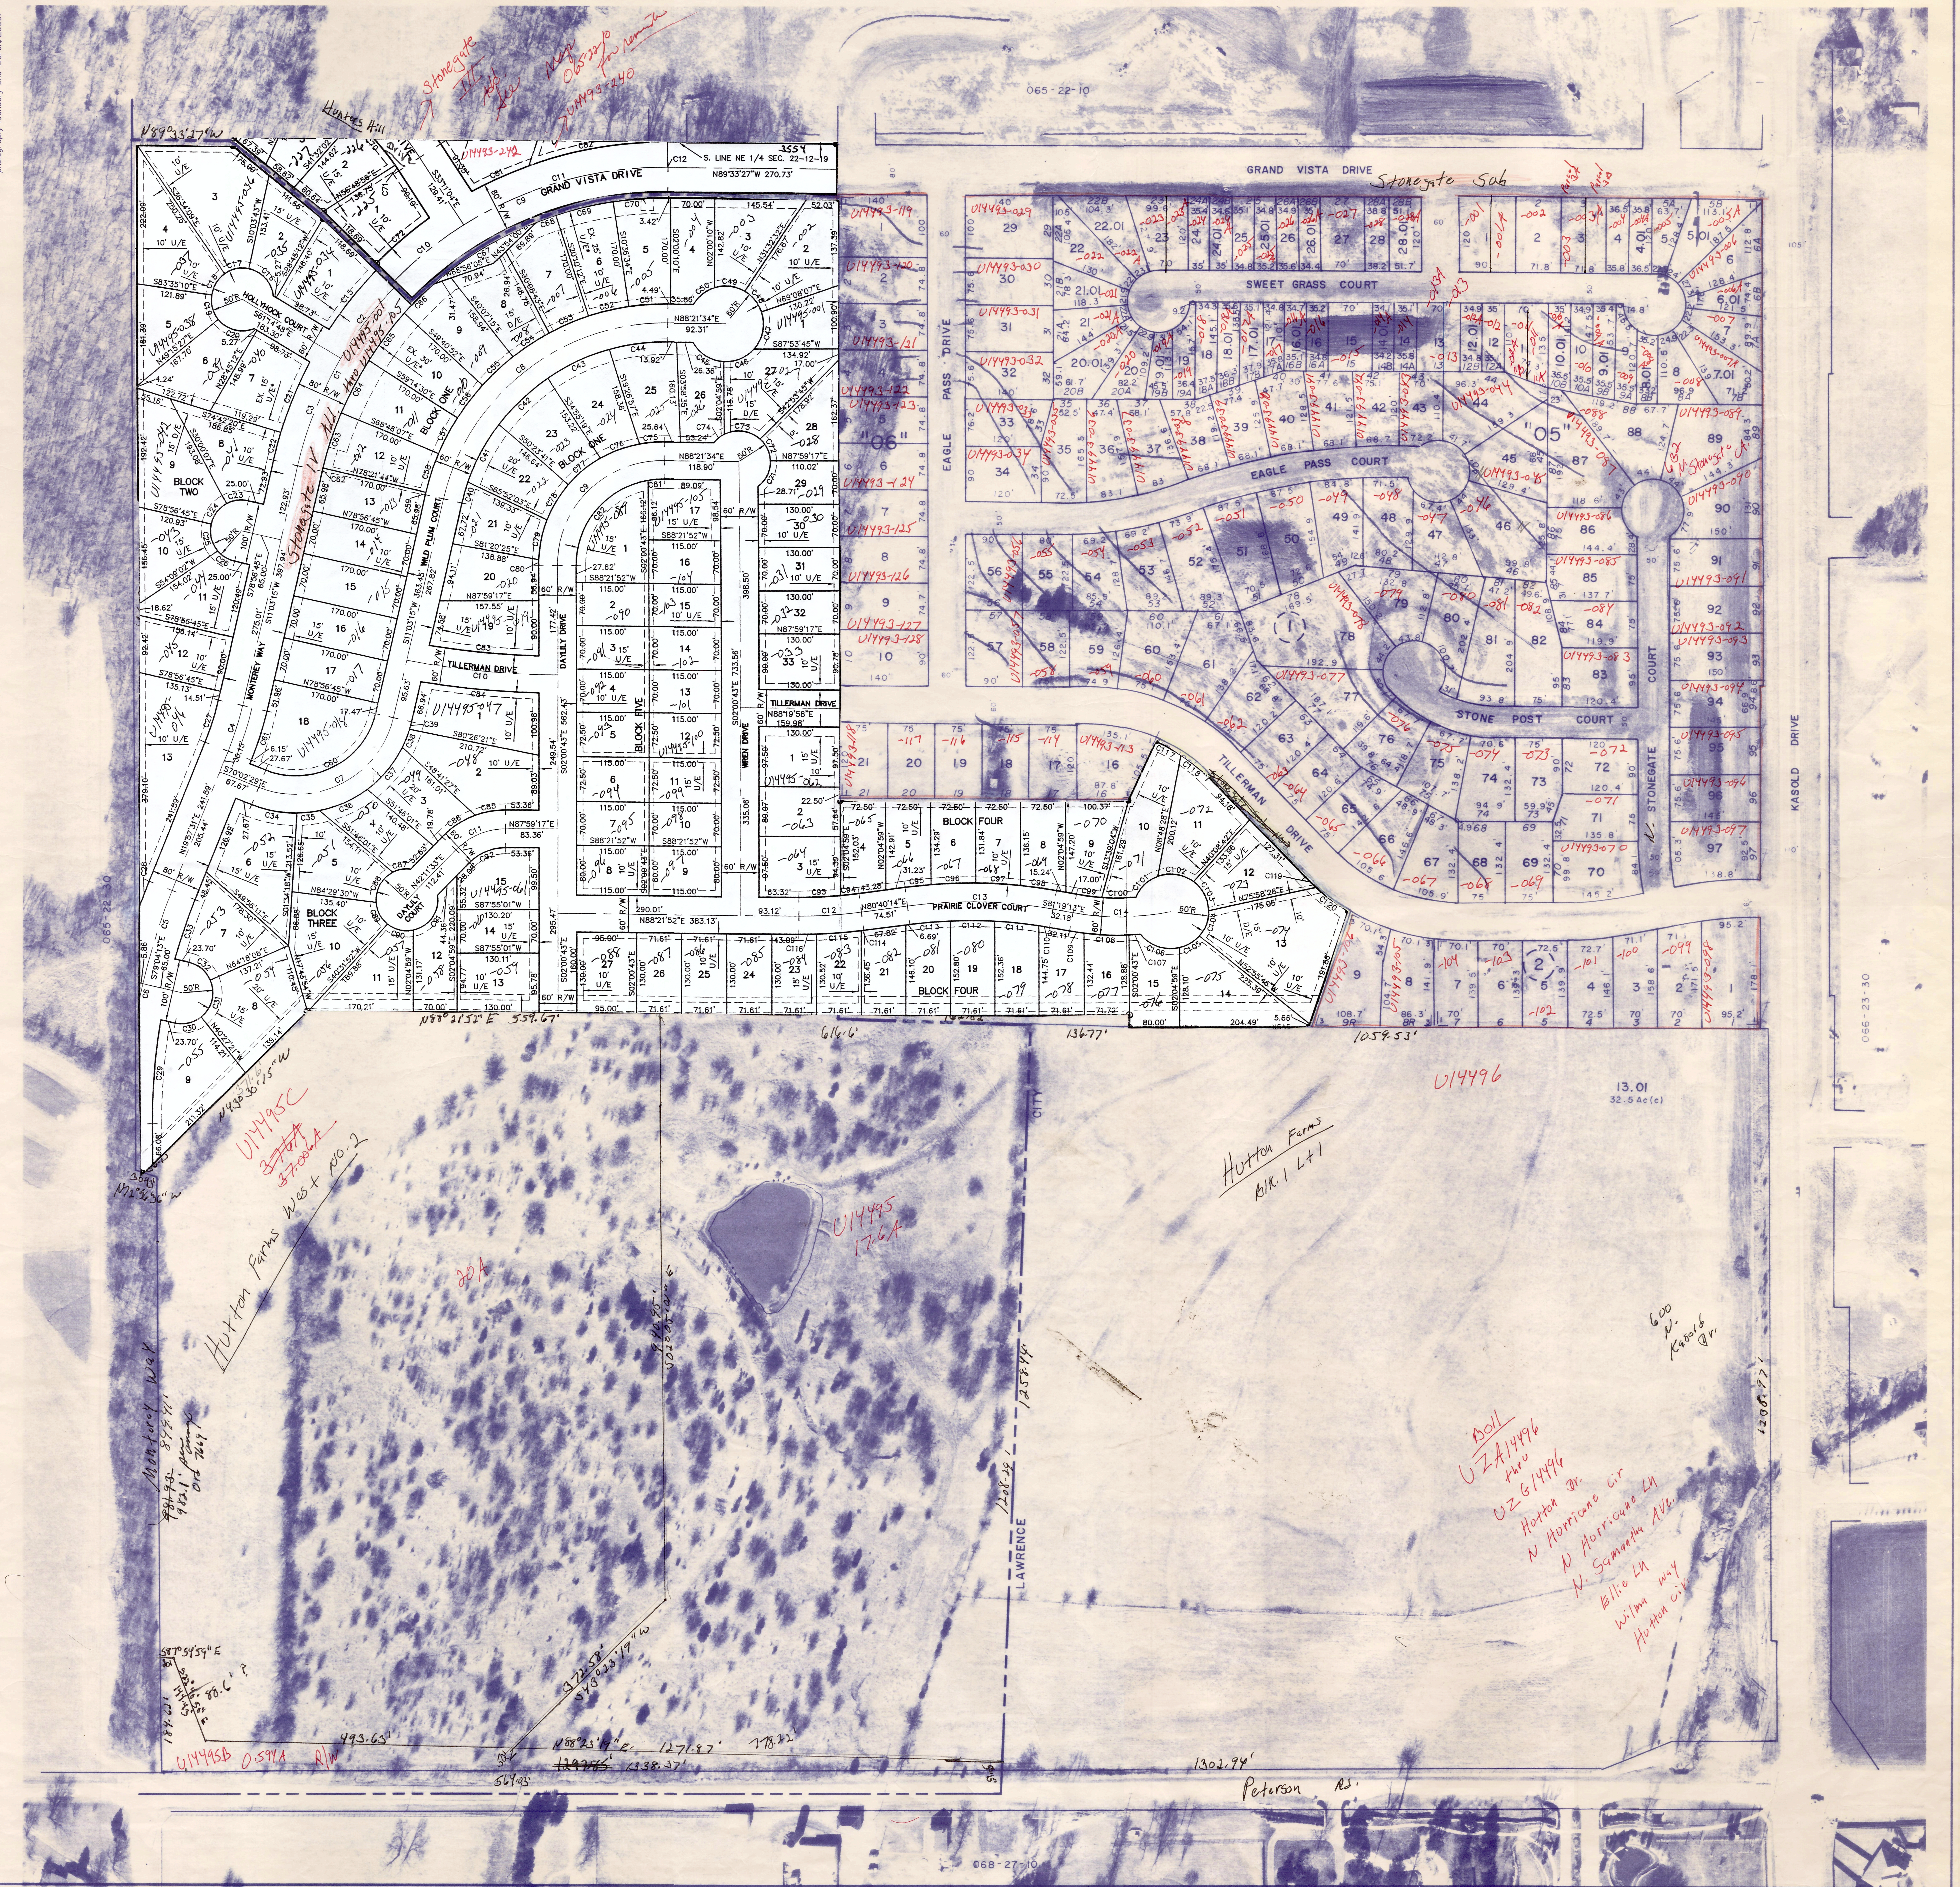
065-22-10
GRAND VISTA DRIVE
Stonegate Sub
SWEET GRASS COURT
EAGLE PASS DRIVE
EAGLE PASS COURT
"06"
"05"
STONE POST COURT
N. STONEGATE COURT
KASOLD DRIVE
TILLERMAN DRIVE
066-23-30
065-22-30
Hunters Hill
Stonegate III Add. See Map 065-22-10 for remainder
U14493-240
U14493-242
S. LINE NE 1/4 SEC. 22-12-19
N89°33'27"W 270.73'
N89°33'27"W
3554
HOLLYHOCK COURT
BLOCK ONE
BLOCK TWO
BLOCK THREE
BLOCK FOUR
BLOCK FIVE
MONTEREY WAY
WILD PLUM COURT
DAYLILY DRIVE
DAYLILY COURT
WREN DRIVE
PRAIRIE CLOVER COURT
Stonegate IV Add
U14495-001 thru U14495-105
N88°21'52"E 559.67'
616.6'
136.77'
1059.53'
U14496
13.01
32.5 Ac(c)
Hutton Farms Blk 1 L+1
600 N. Kasold Dr.
Boll
UZA14496 thru UZG14496
Hutton Dr.
N Hurricane Cir
N Hurricane Ln
N. Samantha Ave.
Ellie Ln
Wilma Way
Hutton Cir.
U14495C
~~37.01A~~ 37.006A
N43°30'15"W
371.6'
Hutton Farms West No. 2
U14495 17.6A
20A
940.95'
S02°05'21"E
Monterey Way
~~981.93'~~ 899.41'
982.1' per annex ord 7669
S87°54'59"E
88.6'
184.61'
493.63'
U14495B 0.594A R/W
372.58'
S43°23'19"W
N88°23'19"E
1271.87'
778.22'
~~1297.85'~~
1338.37'
564.03'
CITY
LAWRENCE
1258.44'
1208.29'
1208.97'
1302.94'
Peterson Rd.
068-27-10

OWNERSHIP MAP

DOUGLAS COUNTY KANSAS

PREPARED UNDER THE DIRECTION OF

KANSAS DEPARTMENT OF REVENUE

DIVISION OF PROPERTY VALUATION

AND

BOARD OF COMMISSIONERS

PREPARED BY

DOUGLAS COUNTY

REVISIONS DATE	BY	DATE	BY	DATE	BY	DATE	BY
11/11/02	DRA						

SUBD NO	SUBDIVISION NAME	PLAT BOOK	PLAT PAGE	SUBD CODE
1	STONEGATE SUBDIVISION	17	121	1843
2	STONEGATE SUBDIVISION NO. 2	17	146	1841
3	LOT SPLIT LTS 8 and 9 OF BLOCK TWO STONEGATE SUB.	17	491	1843

THIS PROPERTY OWNERSHIP MAP IS FOR TAX PURPOSES ONLY
IT IS NOT INTENEDED FOR CONVEYANCES, NOR IS IT A LEGAL SURVEY

LEGEND

TOWNSHIP & RANGE	▬▬	AREA FROM DEED	0.5 Ac(d)
COUNTY LINE	▬ ▬	AREA CALCULATED	10.5 Ac(c)
CORPORATION LINE	— —	DIMENSION FROM DEED	16.5
TAXING UNIT LINE	— —	DIMENSION SCALED	20(s)
R/W LINES	═	SUBDIVISION LOT NUMBER	23
SECTION LINE	─	PARCEL NUMBER	10
PROPERTY LINE	─	WATER	
ORIGINAL LOT LINE		INTERSTATE HIGHWAY	70
LAND HOOK		U.S. HIGHWAY	28
ORIGINAL BLOCK NO	(2)	STATE HIGHWAY	34
ORIGINAL S/D LIMIT	2⊥3	COUNTY ROAD	10
MAP BLOCK NO	"03"	TOWNSHIP ROAD	123
MAP BLOCK LIMIT (WHERE APPLICABLE)	"03" "04"	ROADS, STREETS, CHURCHES, ETC	BY NAME
		SECTION CORNERS	2 1 / 11 12

TOWNSHIP LOCATOR

	R17E	R18E	R19E	R20E	R21E
T11S	03	02	01		
T12S	04	05	06	07	08
T13S	13	12	11	10	09
T14S	14	15	16	17	18
T15S	23	22	21	20	19

MAP SHEET INDEX

6	5	4	3	2	1
7	8	9	10	11	12
18	17	16	15	14	13
19	20	21	22	23	24
30	29	28	27	26	25
31	32	33	34	35	36

1/4 SECTION INDEX

20	10
30	40

10-14-03

SEC. 22 TWP. 12S RNG 19E

MAP NO. 065-22-40 SEP 26 2003

SCALE 1"=100'
DATE OF MAP 11-02
DATE OF PHOTOGRAPHY APRIL 2000
AERIAL PHOTO NO.
PARCEL COUNT 131

N