DOUGLAS COUNTY, KANSAS Date of photography: JANUARY 2000 Scale: 1"=100' SE 1/4 SEC 33 T12S R19E IMAGE: 0683340

MARKHURD
Plats prepared from multiple image sources, resolutions and dates of photography (January and March, 2000)

SUBD NO	SUBDIVISION NAME	PLAT BOOK	PLAT PAGE	SUBD CODE
13	QUAIL RUN NO 4	15	494	1537
14	QUAIL RUN NO 5	15	495	1538
15	OREAD WEST NO 3	15	56	356
16	UNIVERSITY CORPORATE & RESEARCH PARK SUB	[illegible]	[illegible]	1543
17	[illegible]	[illegible]	563	1963
18	[illegible]	5	528	543
19	QUAIL RUN NO 6	15	640	584
20	PARKVIEW 5	15	66	318
21	QUAIL RUN HOLLOW	C1	52	1532

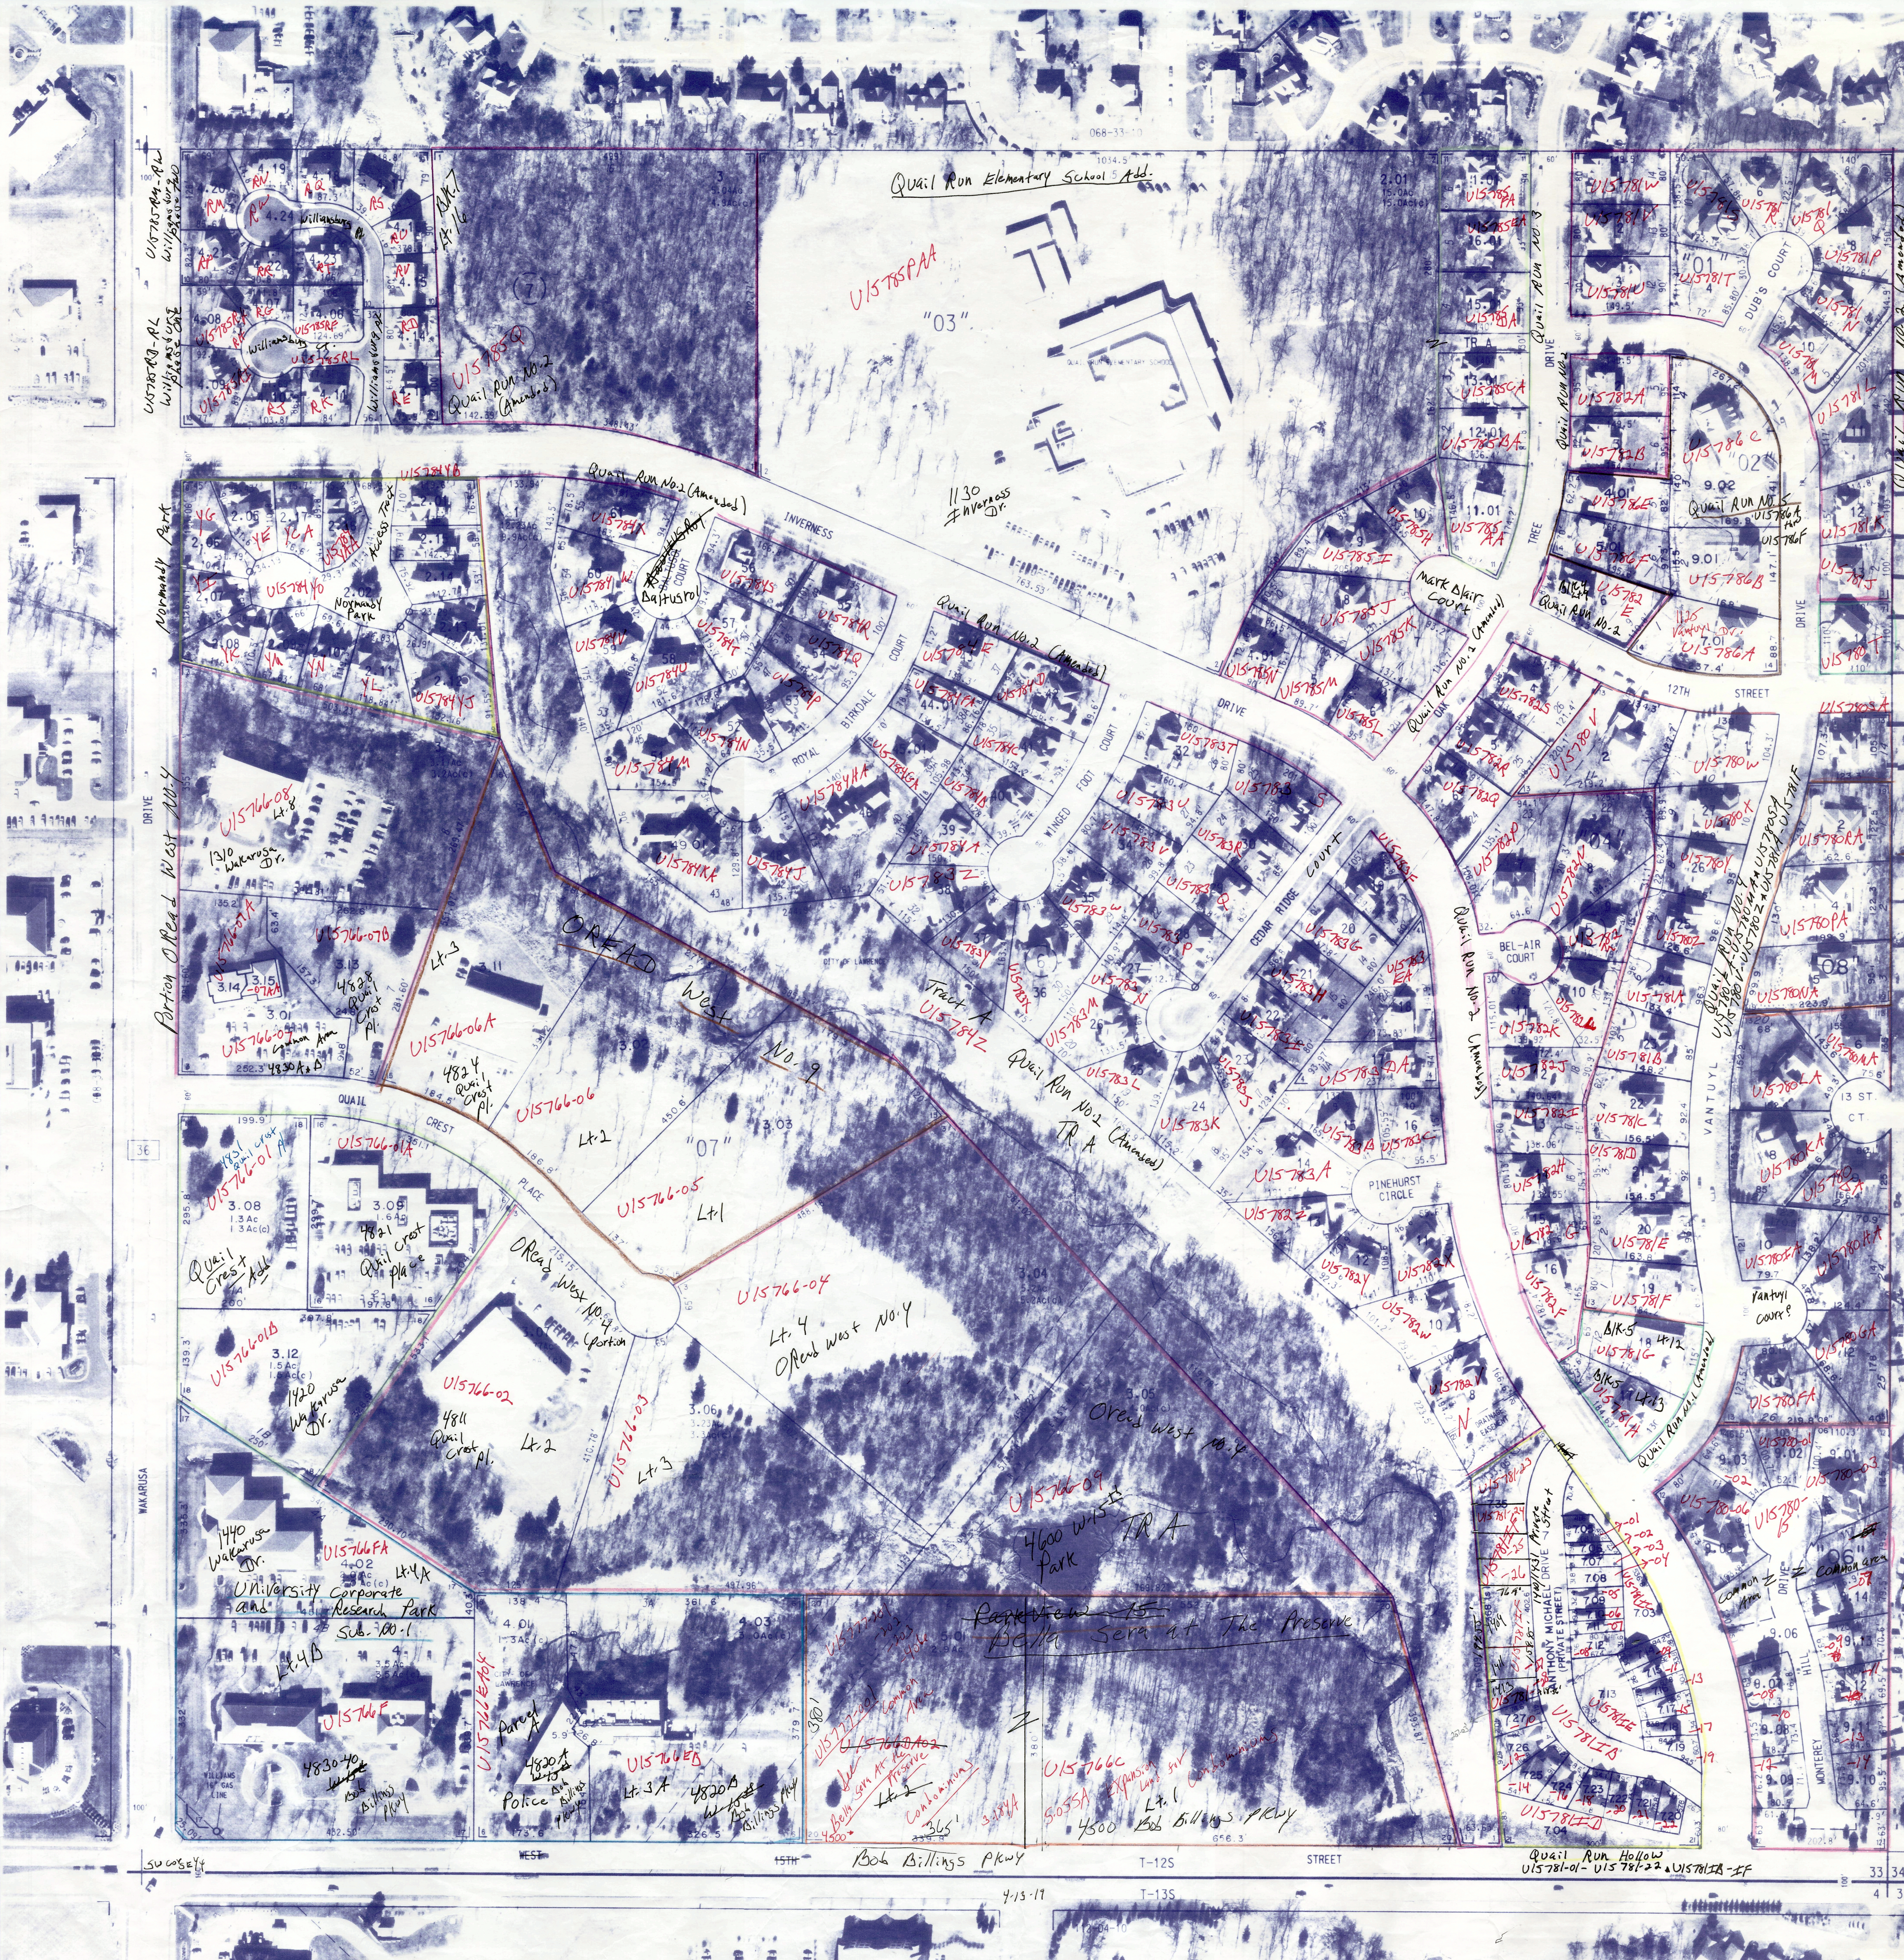

068-33-10
Quail Run Elementary School Add.
QUAIL RUN ELEMENTARY SCHOOL
U15785PAA
"03"
1130 Inverness Dr.
INVERNESS DRIVE
Quail Run No. 2 (Amended)
U15785Q
BLK 7 Lt. 16
Williamsburg Pl.
Williamsburg Ct.
U15785RM-RW Williamsburg Phase Two
U15785RD-RL Williamsburg Phase One
Normandy Park
U15784Y0
U15784YB
U15784YJ
Access Tract
Baltusrol Court
U15784X
U15784W
ROYAL BIRKDALE COURT
WINGED FOOT COURT
CEDAR RIDGE COURT
PINEHURST CIRCLE
Tract A
U15784Z
Quail Run No. 1 TR A (Amended)
U15766-08 Lt. 8
1310 Wakarusa Dr.
Portion Oread West No. 4
U15766-07A
U15766-07B
U15766-07 Common Area
4830 A & B
4828 Quail Crest Pl.
Lt. 3
U15766-06A
4824 Quail Crest Pl.
OREAD West No. 9
U15766-06 Lt. 2
"07"
U15766-05 Lt. 1
U15766-04 Lt. 4 Oread West No. 4
QUAIL CREST PLACE
4831 Quail Crest U15766-01A
U15766-01A
4821 Quail Crest Place
Quail Crest Add.
U15766-01B
1420 Wakarusa Dr.
Oread West No. 4 Portion
U15766-02
4811 Quail Crest Pl. Lt. 2
U15766-03 Lt. 3
Oread West No. 4
U15766-09
4600 W. 15th Park
TR A
1440 Wakarusa Dr.
U15766FA
Lt. 4A
University Corporate and Research Park Sub. No. 1
Lt. 4B
U15766F
4830-40 ~~W. 15th~~ Bob Billings Pkwy
U15766EA04
Parcel A
4820A ~~W. 15th~~ Bob Billings Pkwy
Police
U15766EB
Lt. 3A
4820B ~~W. 15th~~ Bob Billings Pkwy
~~Parkview 15~~
Bella Sera at The Preserve
U15777-001 -201 -202 -203 -406
Common Area
~~U15766A02~~
Bella Sera At The Preserve
Lt. 2
Condominiums
U15766C
5055A Expansion Land for Condominiums
Lt. 1
4500 Bob Billings Pkwy
WAKARUSA DRIVE
WEST 15TH STREET
Bob Billings Pkwy
4-13-19
SW cor SE 1/4
T-12S
T-13S
Mark Blair Court
Quail Run No. 3
Quail Run No. 2
Quail Run No. 1 (Amended)
TREE DRIVE
OAK
12TH STREET
DUB'S COURT
"01"
"02"
Quail Run No. 5 U15786A thru U15786F
1125 Vantuyl Dr.
U15786A
Quail Run No. 1 (Amended) Blk 3 Lt. 1
U15780T
Quail Run No. 6 U15780NA U15780PA U15780RA
Quail Run No. 4 U15780SA-U15780MA & U15781A-U15781F U15780V-U15782
BEL-AIR COURT
VANTUYL DRIVE
13 ST. CT.
Vantuyl Court
"04"
"08"
Blk 5 Lt. 12
Blk 5 Lt. 13
DRAINAGE EASEMENT
ANTHONY MICHAEL DRIVE (PRIVATE STREET)
1401/1431 Private Street
Quail Run Hollow U15781-01 - U15781-22 & U15781A-1F
MONTEREY HILL DRIVE
Common Area
Monterey Hill U15780-01 thru U15780-15
"06"
33 34
4 3

DOUGLAS COUNTY, KANSAS

KANSAS DEPARTMENT OF REVENUE
DIVISION OF PROPERTY VALUATION

BOARD OF COMMISSIONERS

DOUGLAS COUNTY

REVISIONS DATE	BY	DATE	BY	DATE	BY	DATE	BY
6/21/00	RWN	11/04/91	DRA	[illegible]	[illegible]		
11/4/00	TWV	[illegible]	SLT	[illegible]	SLT		
7/12/01	SWM	4/21/92	DRA	3/23/94	[illegible]		
4/18/91	DRA	[illegible]	DRA	[illegible]	[illegible]		

LEGEND

TOWNSHIP LOCATOR

MAP SHEET INDEX

1/4 SECTION INDEX

THIS PROPERTY OWNERSHIP MAP IS FOR TAX PURPOSES ONLY. IT IS NOT INTENDED FOR CONVEYANCES NOR IS IT A LEGAL SURVEY.

SEC 33 TWP 12S RNG 19E

MAP NO 068-33-40

AUG 21 2002

10-30-02