DOUGLAS COUNTY, KANSAS Date of photography: 3-29-86 Scale: 1"= 400' T 12 S, R 18 E Exp.No. 2-06

UNITED AERIAL MAPPING
5411 JACKWOOD DRIVE · SAN ANTONIO, TEXAS 78238 · (512) 684-

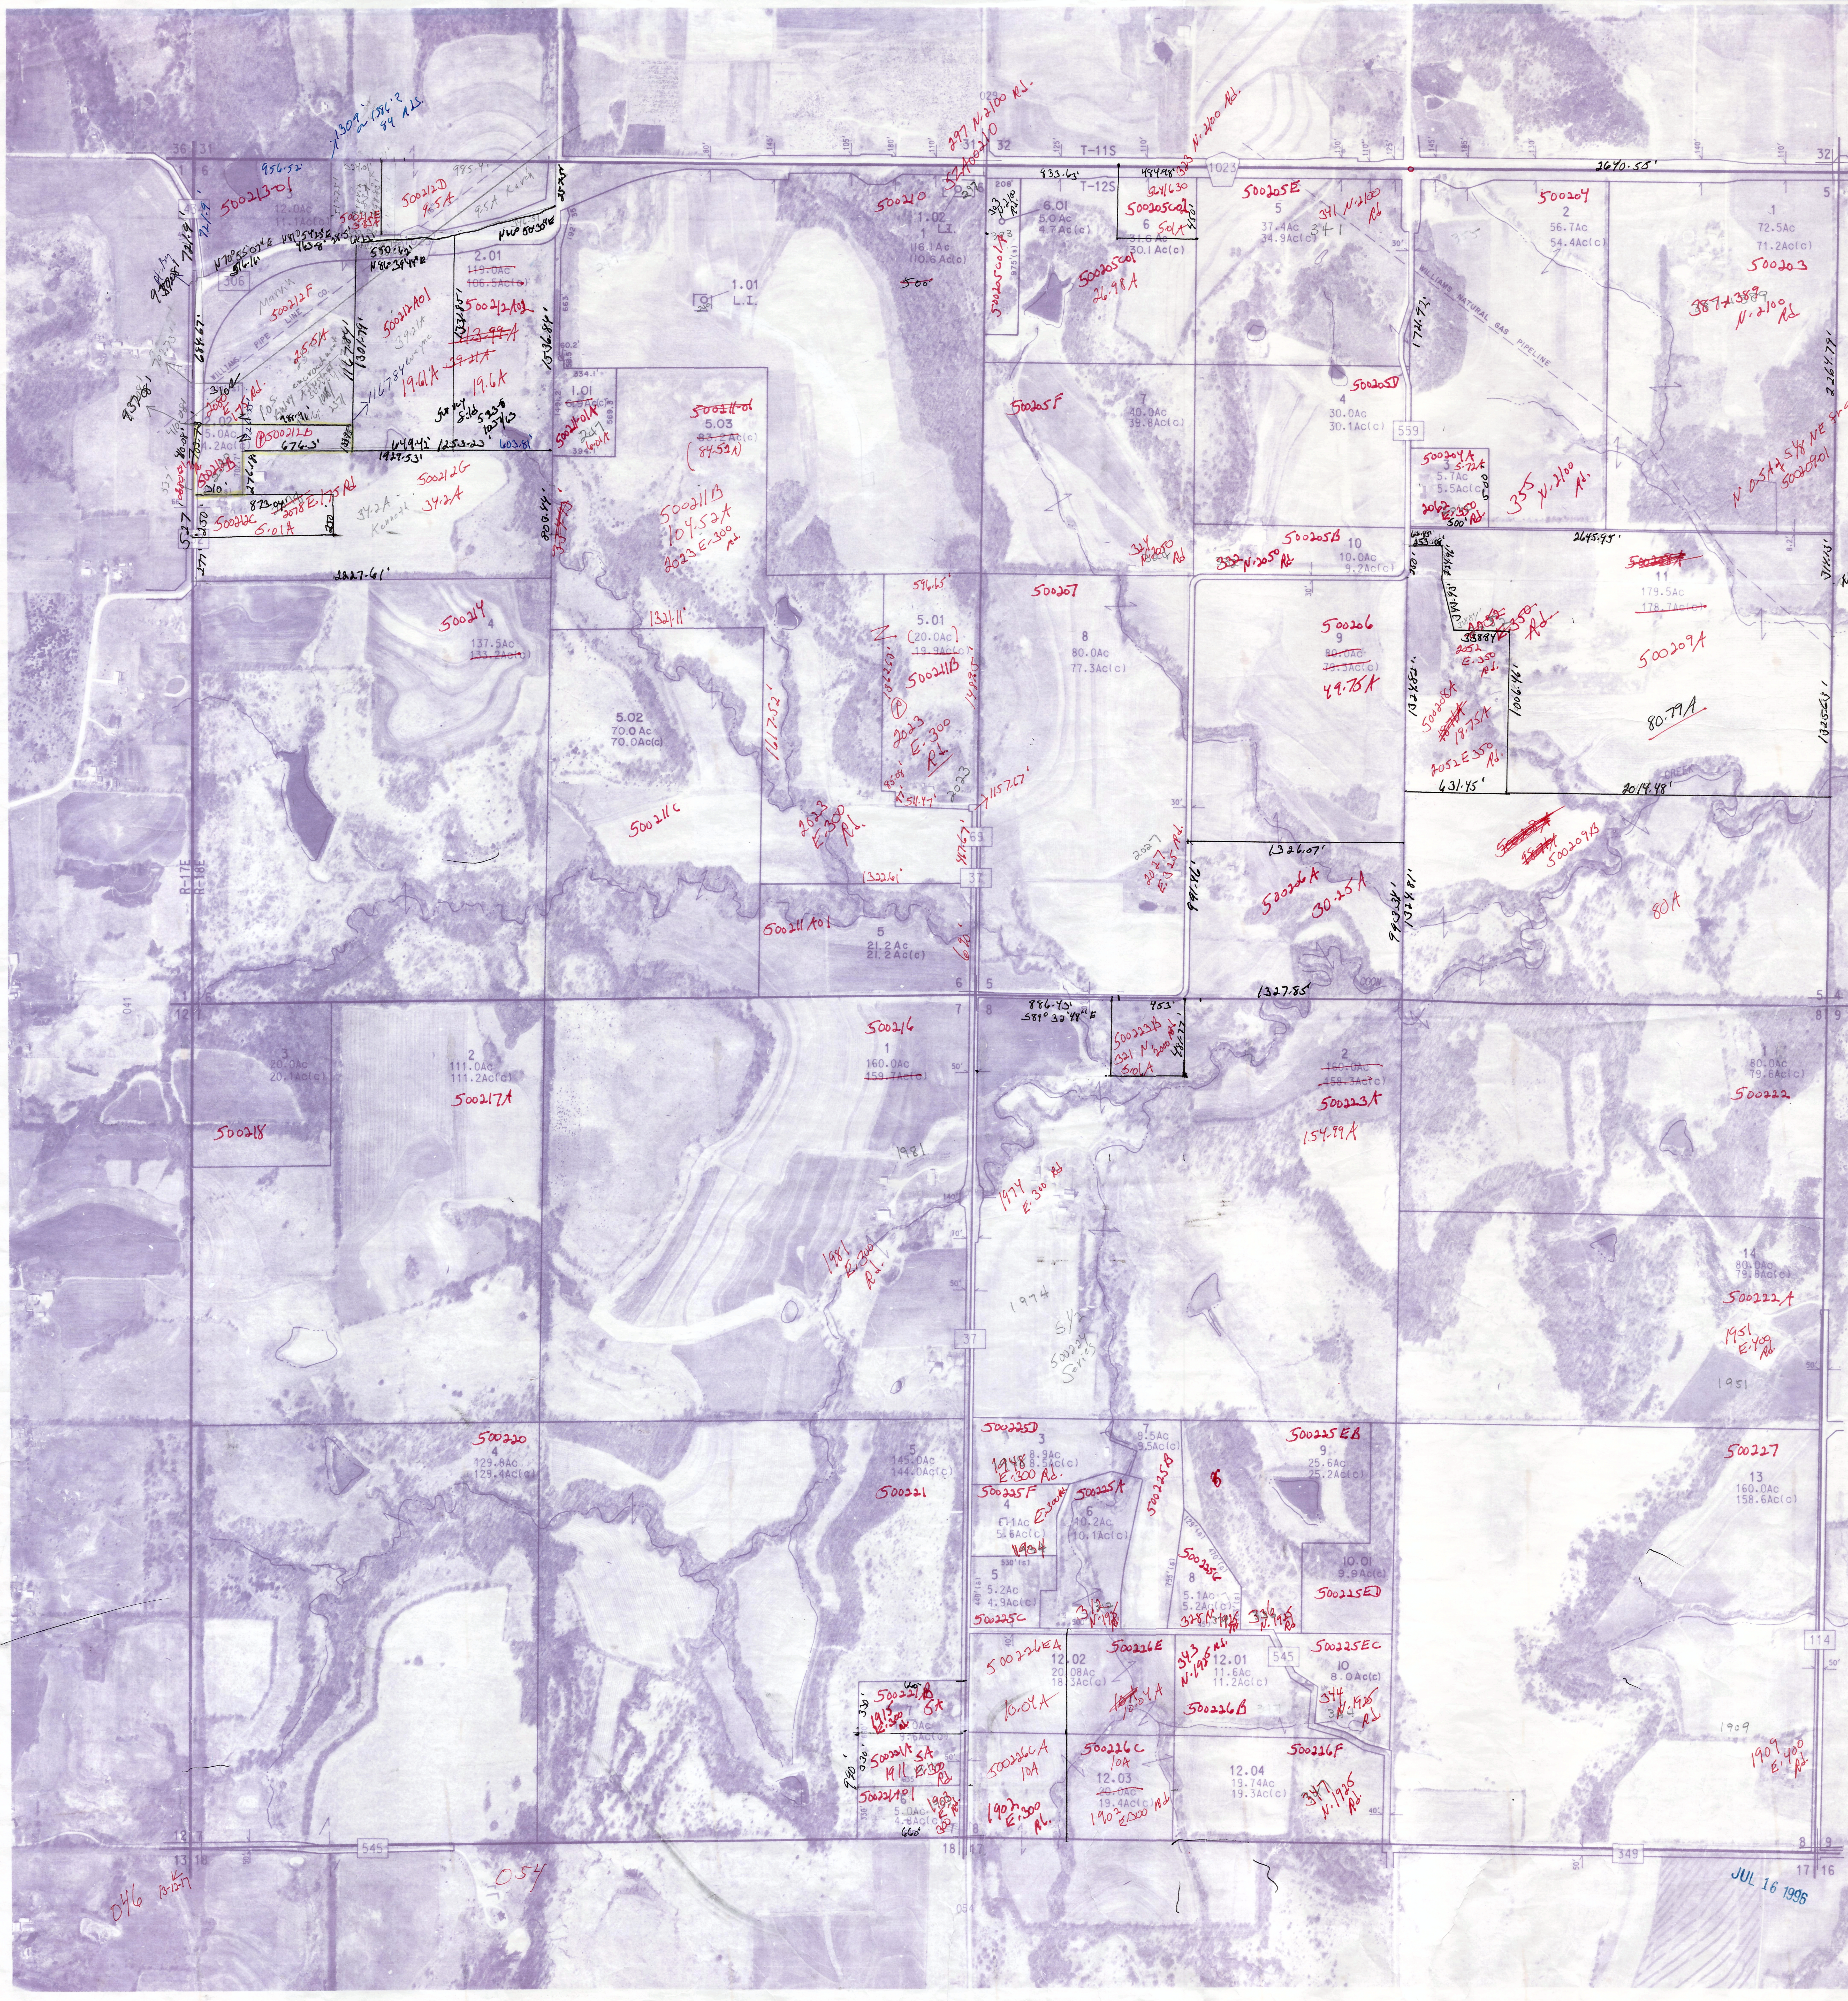
6|5
7|8
T-11S
T-12S
R-17E
R-18E
36 31
1 6
31 32
32 33
5 4
6 5
7 8
8 9
12 7
13 18
18 17
17 16
1023
306
434
527
559
69
37
545
349
114
041
052
054
WILLIAMS PIPE LINE CO.
WILLIAMS NATURAL GAS PIPELINE
COON CREEK
3
12.0Ac
11.1Ac(c)
500213-01
956.52'
1309 or 1356.2 84 Rd.
500212E
500212D
9.5A
9.5A Karen
985.41'
2.01
~~119.0Ac~~
~~106.5Ac(c)~~
500212A01
39.21A
500212A02
~~113.99A~~
~~39.21A~~
19.61A
19.6A
500212F
Marvin
25.51A
500212B
2.02
5.0Ac
4.2Ac(c)
2080 E 175 Rd.
500212C
5.01A
500212G
34.2A
Kenneth
2078 E 175 Rd.
676.3'
1929.53'
1253.23'
603.81'
2227.61'
1536.84'
1301.79'
1167.84'
684.67'
721.9'
N 70°55'07" E
N 81°54'25" E
N 86°39'44" E
N 60°50'30" E
1.01
6.9Ac(c)
500211-01A
247
6.01A
5.03
~~500211-01~~
83.2Ac(c)
(84.52A)
500211B
104.52A
2023 E. 300 Rd.
1.01
L.I.
1.02
L.I.
1
116.1Ac
110.6Ac(c)
500210
297 N. 2100 Rd.
6.01
5.0Ac
4.7Ac(c)
303 N. 2100 Rd.
500205C01A
500205C01
26.98A
500205C02
5.01A
6
31.6Ac
30.1Ac(c)
833.63'
323 N. 2100 Rd.
500205E
5
37.4Ac
34.9Ac(c)
341 N. 2100 Rd.
500205F
7
40.0Ac
39.8Ac(c)
500205D
4
30.0Ac
30.1Ac(c)
500205B
10
10.0Ac
9.2Ac(c)
332 N. 2050 Rd.
324 N. 2050 Rd.
500204
2
56.7Ac
54.4Ac(c)
1
72.5Ac
71.2Ac(c)
500203
387 389 N. 2100 Rd.
2640.55'
500204A
3
5.7Ac
5.5Ac(c)
5.72A
2062 E 350 Rd.
355 N. 2100 Rd.
N 0.5A of S 1/8 NE Sr 9r
500209-01
2264.79'
2645.95'
~~500209A~~
11
179.5Ac
~~178.7Ac(c)~~
500209A
80.79A
NE cor SE 9r.
500208A
18.75A
2052 E. 350 Rd.
2051 E 350 Rd.
631.45'
2014.48'
~~500209B~~
500209B
80A
500214
4
137.5Ac
~~133.2Ac(c)~~
5.02
70.0Ac
70.0Ac(c)
500211C
2023 E. 300 Rd.
1321.11'
1617.52'
1322.61'
5.01
(20.0Ac)
~~19.9Ac(c)~~
500211B
2023 E. 300 Rd.
596.65'
1489.5'
1157.67'
500211A01
5
21.2Ac
21.2Ac(c)
500207
8
80.0Ac
77.3Ac(c)
2027 E. 325 Rd.
500206
9
~~80.0Ac~~
~~79.3Ac(c)~~
49.75A
1326.07'
500206A
30.25A
991.46'
1327.85'
886.43'
S 89°32'48" E
500223B
321 N 2000 Rd.
5.01A
453'
481.77'
500216
1
160.0Ac
~~159.7Ac(c)~~
1981
1981 E. 300 Rd.
1974
1974 E. 300 Rd.
S 1/2
500224 Series
3
20.0Ac
20.1Ac(c)
500218
2
111.0Ac
111.2Ac(c)
500217A
2
~~160.0Ac~~
~~158.3Ac(c)~~
500223A
154.99A
1
80.0Ac
79.6Ac(c)
500222
14
80.0Ac
79.8Ac(c)
500222A
1951 E. 400 Rd.
1951
500220
4
129.8Ac
129.4Ac(c)
5
145.0Ac
144.0Ac(c)
500221
500225D
3
8.9Ac
8.5Ac(c)
1948 E. 300 Rd.
500225F
4
6.1Ac
5.6Ac(c)
1934 E. 300 Rd.
500225A
6
10.2Ac
10.1Ac(c)
7
9.5Ac
9.5Ac(c)
500225B
5
5.2Ac
4.9Ac(c)
500225C
312 N. 1925
500225G
8
5.1Ac
5.2Ac(c)
328 N. 1925
336 N. 1925 Rd.
500225EB
9
25.6Ac
25.2Ac(c)
10.01
9.9Ac(c)
500225ED
500225EC
10
8.0Ac(c)
344 N. 1926 Rd.
500227
13
160.0Ac
158.6Ac(c)
1909
1909 E. 400 Rd.
500226EA
12.02
20.08Ac
18.3Ac(c)
10.04A
500226E
12.01
11.6Ac
11.2Ac(c)
343 N. 1925 Rd.
500226B
500226F
12.04
19.74Ac
19.3Ac(c)
347 N. 1926 Rd.
500221B
5A
1915 E. 300 Rd.
7
10.0Ac
9.6Ac(c)
500221A
5A
1911 E. 300 Rd.
500221A01
6
5.0Ac
4.8Ac(c)
1903 E. 300 Rd.
990'
660'
500226CA
10A
1902 E. 300 Rd.
500226C
10A
12.03
~~20.0Ac~~
19.4Ac(c)
1902 E. 300 Rd.
046 13-12-17
054
JUL 16 1996

OWNERSHIP MAP
DOUGLAS COUNTY, KANSAS
PREPARED UNDER THE DIRECTION OF
KANSAS DEPARTMENT OF REVENUE
DIVISION OF PROPERTY VALUATION
AND
BOARD OF COMMISSIONERS
PREPARED BY
DOUGLAS COUNTY

REVISIONS DATE	BY	DATE	BY	DATE	BY	DATE	BY
1/3/89	DRA	2/09/93	SLT				
6/26/91	DRA	1/18/94	DRA				
2/20/92	SLT	8/16/94	DRA				
3/17/92	DRA	10/26/94	DRA				

SUBD NO	SUBDIVISION NAME	PLAT BOOK	PLAT PAGE	SUBD CODE

THIS PROPERTY OWNERSHIP MAP IS FOR TAX PURPOSES ONLY
IT IS NOT INTENEDED FOR CONVEYANCES, NOR IS IT A LEGAL SURVEY

LEGEND

TOWNSHIP & RANGE		AREA FROM DEED	0.5 Ac(d)
COUNTY LINE		AREA CALCULATED	0.5 Ac(c)
CORPORATION LINE		DIMENSION FROM DEED	165'
TAXING UNIT LINE		DIMENSION SCALED	20'(s)
R/W LINES		SUBDIVISION LOT NUMBER	23
SECTION LINE		PARCEL NUMBER	10
PROPERTY LINE		WATER	
ORIGINAL LOT LINE		INTERSTATE HIGHWAY	70
LAND HOOK		U.S. HIGHWAY	28
		STATE HIGHWAY	34
ORIGINAL BLOCK NO	(2)	COUNTY ROAD	10
ORIGINAL S/D LIMIT		TOWNSHIP ROAD	123
MAP BLOCK NO	"03"	ROADS, STREETS, CHURCHES, ETC.	BY NAME
MAP BLOCK LIMIT (WHERE APPLICABLE)	"03" "04"	SECTION CORNERS	2 1 11 12

TOWNSHIP LOCATOR

MAP SHEET INDEX

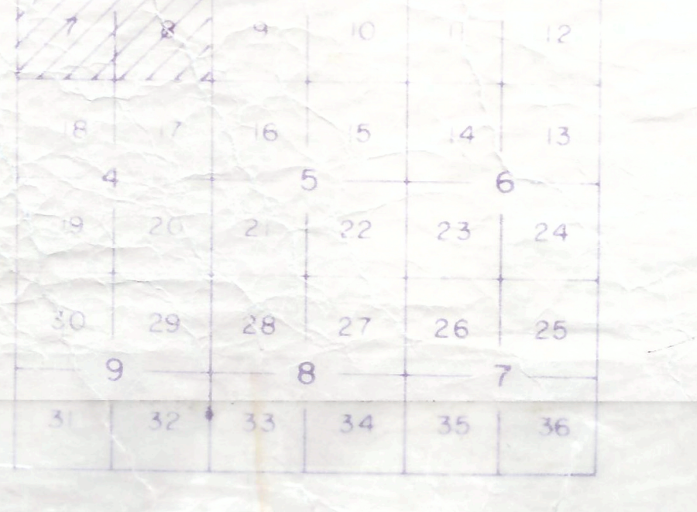
6
5
4
3
2
1
3
2
7
8
9
10
11
12
18
17
16
15
14
13
4
5
6
19
20
21
22
23
24
30
29
28
27
26
25
9
8
7
31
32
33
34
35
36

1/4 SECTION INDEX

JUL 16 1996

SEC 5,6,7,8 TWP 12S RNG 18E

MAP NO 053 NOV 16 1994

SCALE 1"=400'
DATE OF MAP 11-88
DATE OF PHOTOGRAPHY 3-29-86
AERIAL PHOTO NO 2-06
PARCEL COUNT 50

053