DOUGLAS COUNTY, KANSAS   Date of photography: 4-6-86   Scale: 1"=100'   NW Sec. ~~12~~ 13 , T ~~13~~ 12 S , R 17 E   Exp.No. 3-08

UAM UNITED AERIAL MAPPING
5411 JACKWOOD DRIVE · SAN ANTONIO, TEXAS 78238 · (512) 684 2147

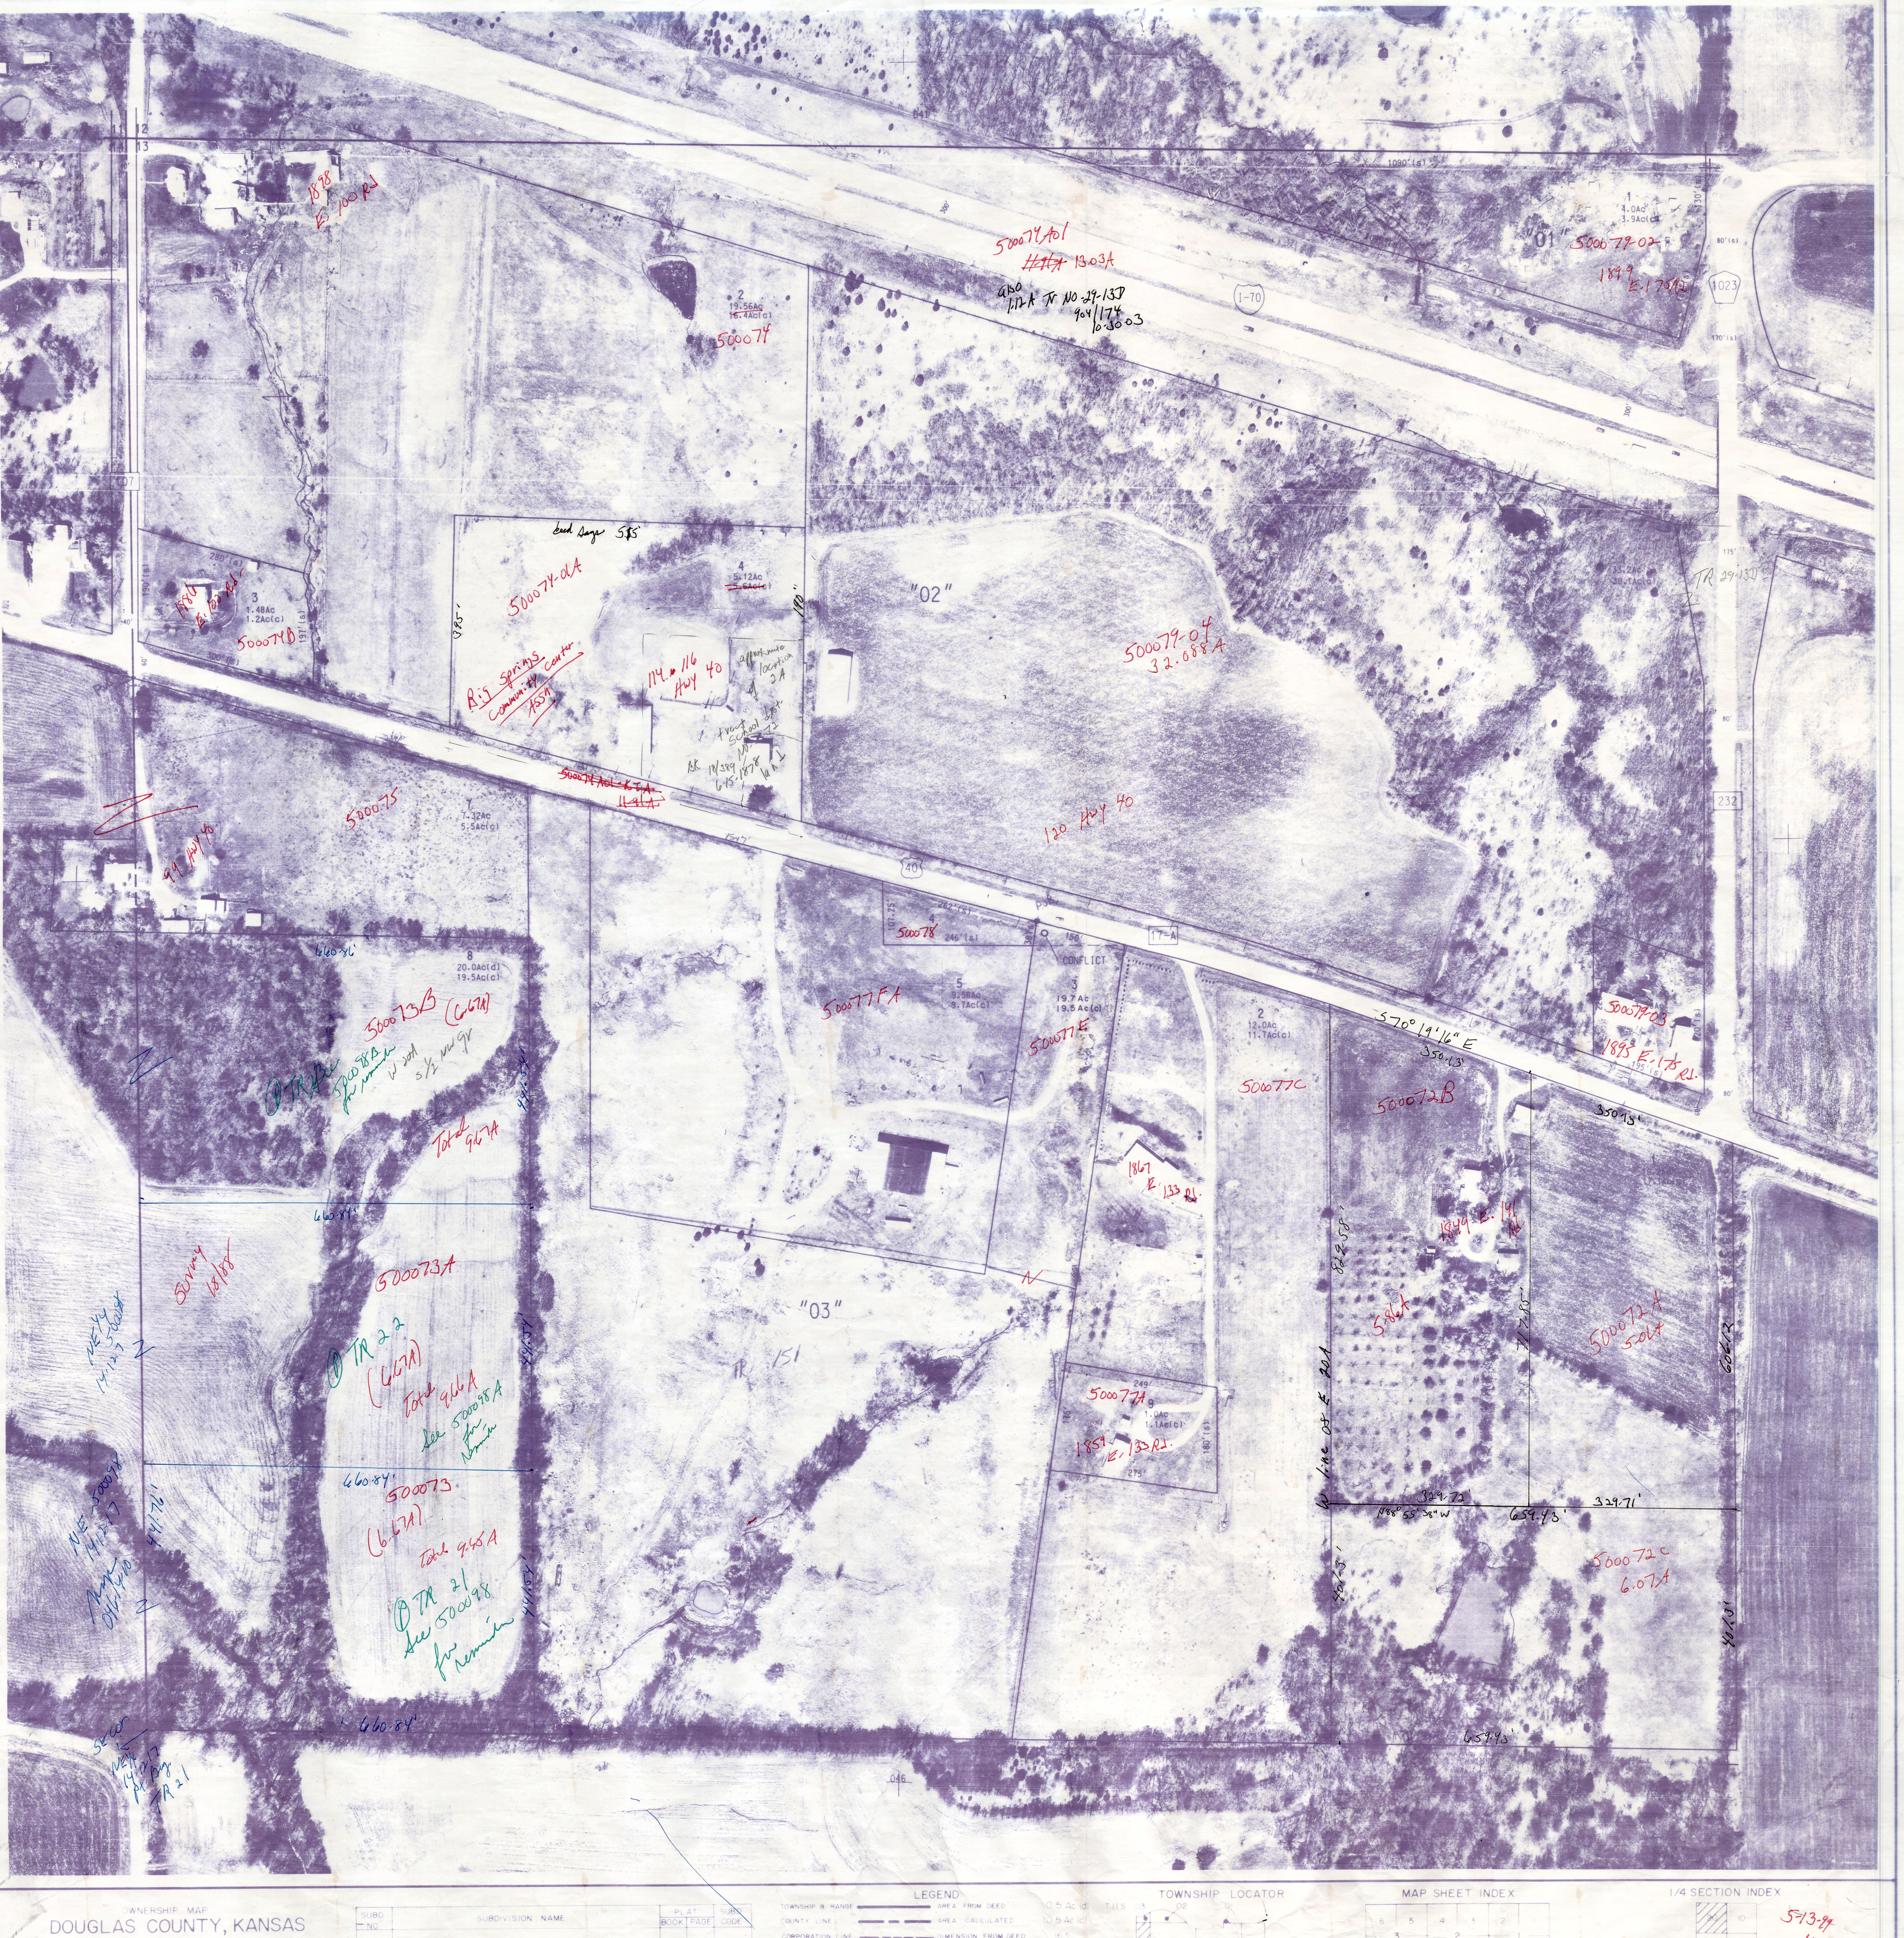
11 12
14 13
1888 E. 100 Rd
2
19.56Ac
~~16.4Ac(c)~~
500074
500074A01
~~11.91A~~ 13.03A
also 1.12A Tr NO-29-13D 904/174 10-30-03
300'
I-70
1
4.0Ac
3.9Ac(c)
"01"
500079-02
1899 E. 175 Rd
1090'(s)
130'(s)
80'(s)
1023
170'(s)
107
280'(s)
3
1.48Ac
1.2Ac(c)
1886 E. 100 Rd
500074B
190'(s)
197'(s)
300'(s)
40'
60'
Deed says 585'
385'
4
5.12Ac
~~5.6Ac(c)~~
500074-01A
Big Springs Community Center Assn
114 & 116 Hwy 40
approximate location 2A
tract school dist. No. 72
Bk 18/389 6-15-1878
~~500074A01-6.7A~~
~~11.91A~~
190'
"02"
500079-04
32.088A
120 Hwy 40
1
33.2Ac
30.1Ac(c)
TR 29-13D
175'
80'
232
7
7.32Ac
5.5Ac(c)
500075
99 Hwy 40
154'
40
4
262'(s)
246'(s)
107.25'
500078
38'(s)
150'
17-A
CONFLICT
5
9.56Ac
9.7Ac(c)
500077FA
3
19.7 Ac
19.5 Ac(c)
500077E
2
12.0Ac
11.7Ac(c)
500077C
S70° 19' 16" E
350.13'
350.13'
500072B
500079-03
1895 E. 175 Rd.
195'(s)
120'(s)
80'
60'
1867 E. 133 Rd.
1849 E. 141 Rd
829.58'
5.86A
717.85'
500072A
5.01A
606.12
8
20.0Ac(d)
19.5Ac(c)
660.86'
500073B (6.67A)
TR 23 500098B for remainder
W 20A S 1/2 NW qr
Total 9.67A
441.54'
660.84'
Survey 1888
500073A
TR 22
(6.67A)
Total 9.66A
See 500098A for remainder
NE 1/4 14-12-17 500098
660.84'
500073
(6.67A)
Total 9.48A
TR 21 See 500098 for remainder
NE 1/4 14-12-17
Map 046-14-10
441.76'
441.54'
441.54'
660.84'
SE cor NE 1/4 14-12-17 Pt. Beg. TR 21
"03"
TR 151
249'
500077A
9
1.0Ac
1.1Ac(c)
1859 E. 133 Rd.
176'
180'(s)
275'
W line of E 20A
329.72'
N88° 55' 38" W
659.43'
329.71'
401.3'
500072C
6.07A
401.3'
659.43'
046
046

OWNERSHIP MAP
DOUGLAS COUNTY, KANSAS
PREPARED UNDER THE DIRECTION OF
KANSAS DEPARTMENT OF REVENUE
DIVISION OF PROPERTY VALUATION
AND
BOARD OF COMMISSIONERS
PREPARED BY
DOUGLAS COUNTY

REVISIONS DATE	BY	DATE	BY	DATE	BY	DATE	BY
3/26/92	DRA						

SUBD NO	SUBDIVISION NAME	PLAT BOOK	PLAT PAGE	SUBD CODE

THIS PROPERTY OWNERSHIP MAP IS FOR TAX PURPOSES ONLY
IT IS NOT INTENEDED FOR CONVEYANCES, NOR IS IT A LEGAL SURVEY

LEGEND

TOWNSHIP & RANGE		AREA FROM DEED	10.5 Ac(d)
COUNTY LINE		AREA CALCULATED	10.5 Ac(c)
CORPORATION LINE		DIMENSION FROM DEED	16.5
TAXING UNIT LINE		DIMENSION SCALED	20'(s)
R/W LINES		SUBDIVISION LOT NUMBER	23
SECTION LINE		PARCEL NUMBER	10
PROPERTY LINE		WATER	
ORIGINAL LOT LINE		INTERSTATE HIGHWAY	70
		U.S. HIGHWAY	28
LAND HOOK		STATE HIGHWAY	34
ORIGINAL BLOCK NO	②	COUNTY ROAD	10
ORIGINAL S/D LIMIT		TOWNSHIP ROAD	123
MAP BLOCK NO	"03"	ROADS, STREETS, CHURCHES, ETC.	NAME
MAP BLOCK LIMIT (WHERE APPLICABLE)	"03" "04"	SECTION CORNERS	2 1 / 11 12

TOWNSHIP LOCATOR

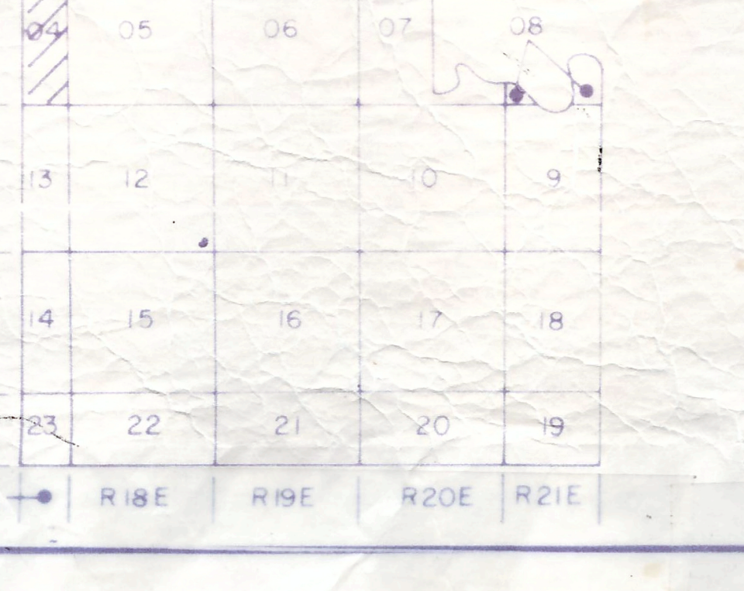
T11S 03 02 01
T12S 04 05 06 07 08
T13S 13 12 11 10 9
T14S 14 15 16 17 18
T15S 23 22 21 20 19
R17E R18E R19E R20E R21E

MAP SHEET INDEX

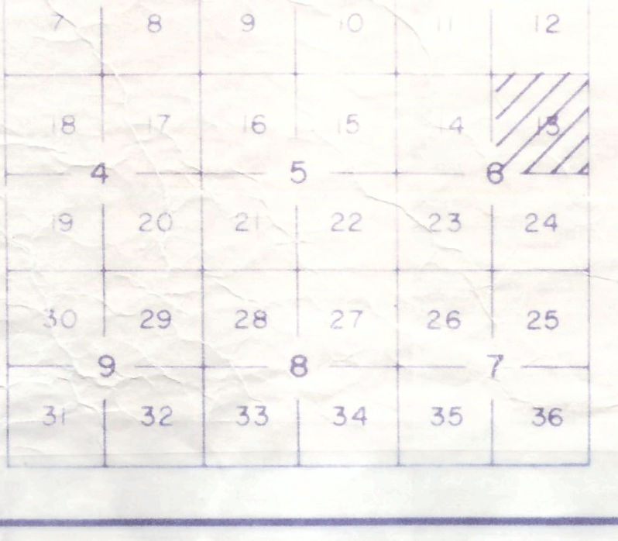
6 5 4 3 2 1
3 2 1
7 8 9 10 11 12
18 17 16 15 14 13
4 5 6
19 20 21 22 23 24
30 29 28 27 26 25
9 8 7
31 32 33 34 35 36

1/4 SECTION INDEX

20	10
30	40

5-13-99
[illegible]

SEC. 13 TWP. 12S RNG. 17E

MAP NO. 046-13-20

MAY 07 1999

SCALE 1"=100
DATE OF MAP 12-88
DATE OF PHOTOGRAPHY 3-27-86
AERIAL PHOTO NO. 3-08
PARCEL COUNT 14

N

046-13-20