UNITED AERIAL MAPPING
5411 JACKWOOD DRIVE · SAN ANTONIO, TEXAS 78238 · (512) 684-7...

DOUGLAS COUNTY, KANSAS   Date of photography: 3-29-86   Scale: 1" = 400'   14|13 23|24   T 13 S , R 20 E   Exp.No. 6-27

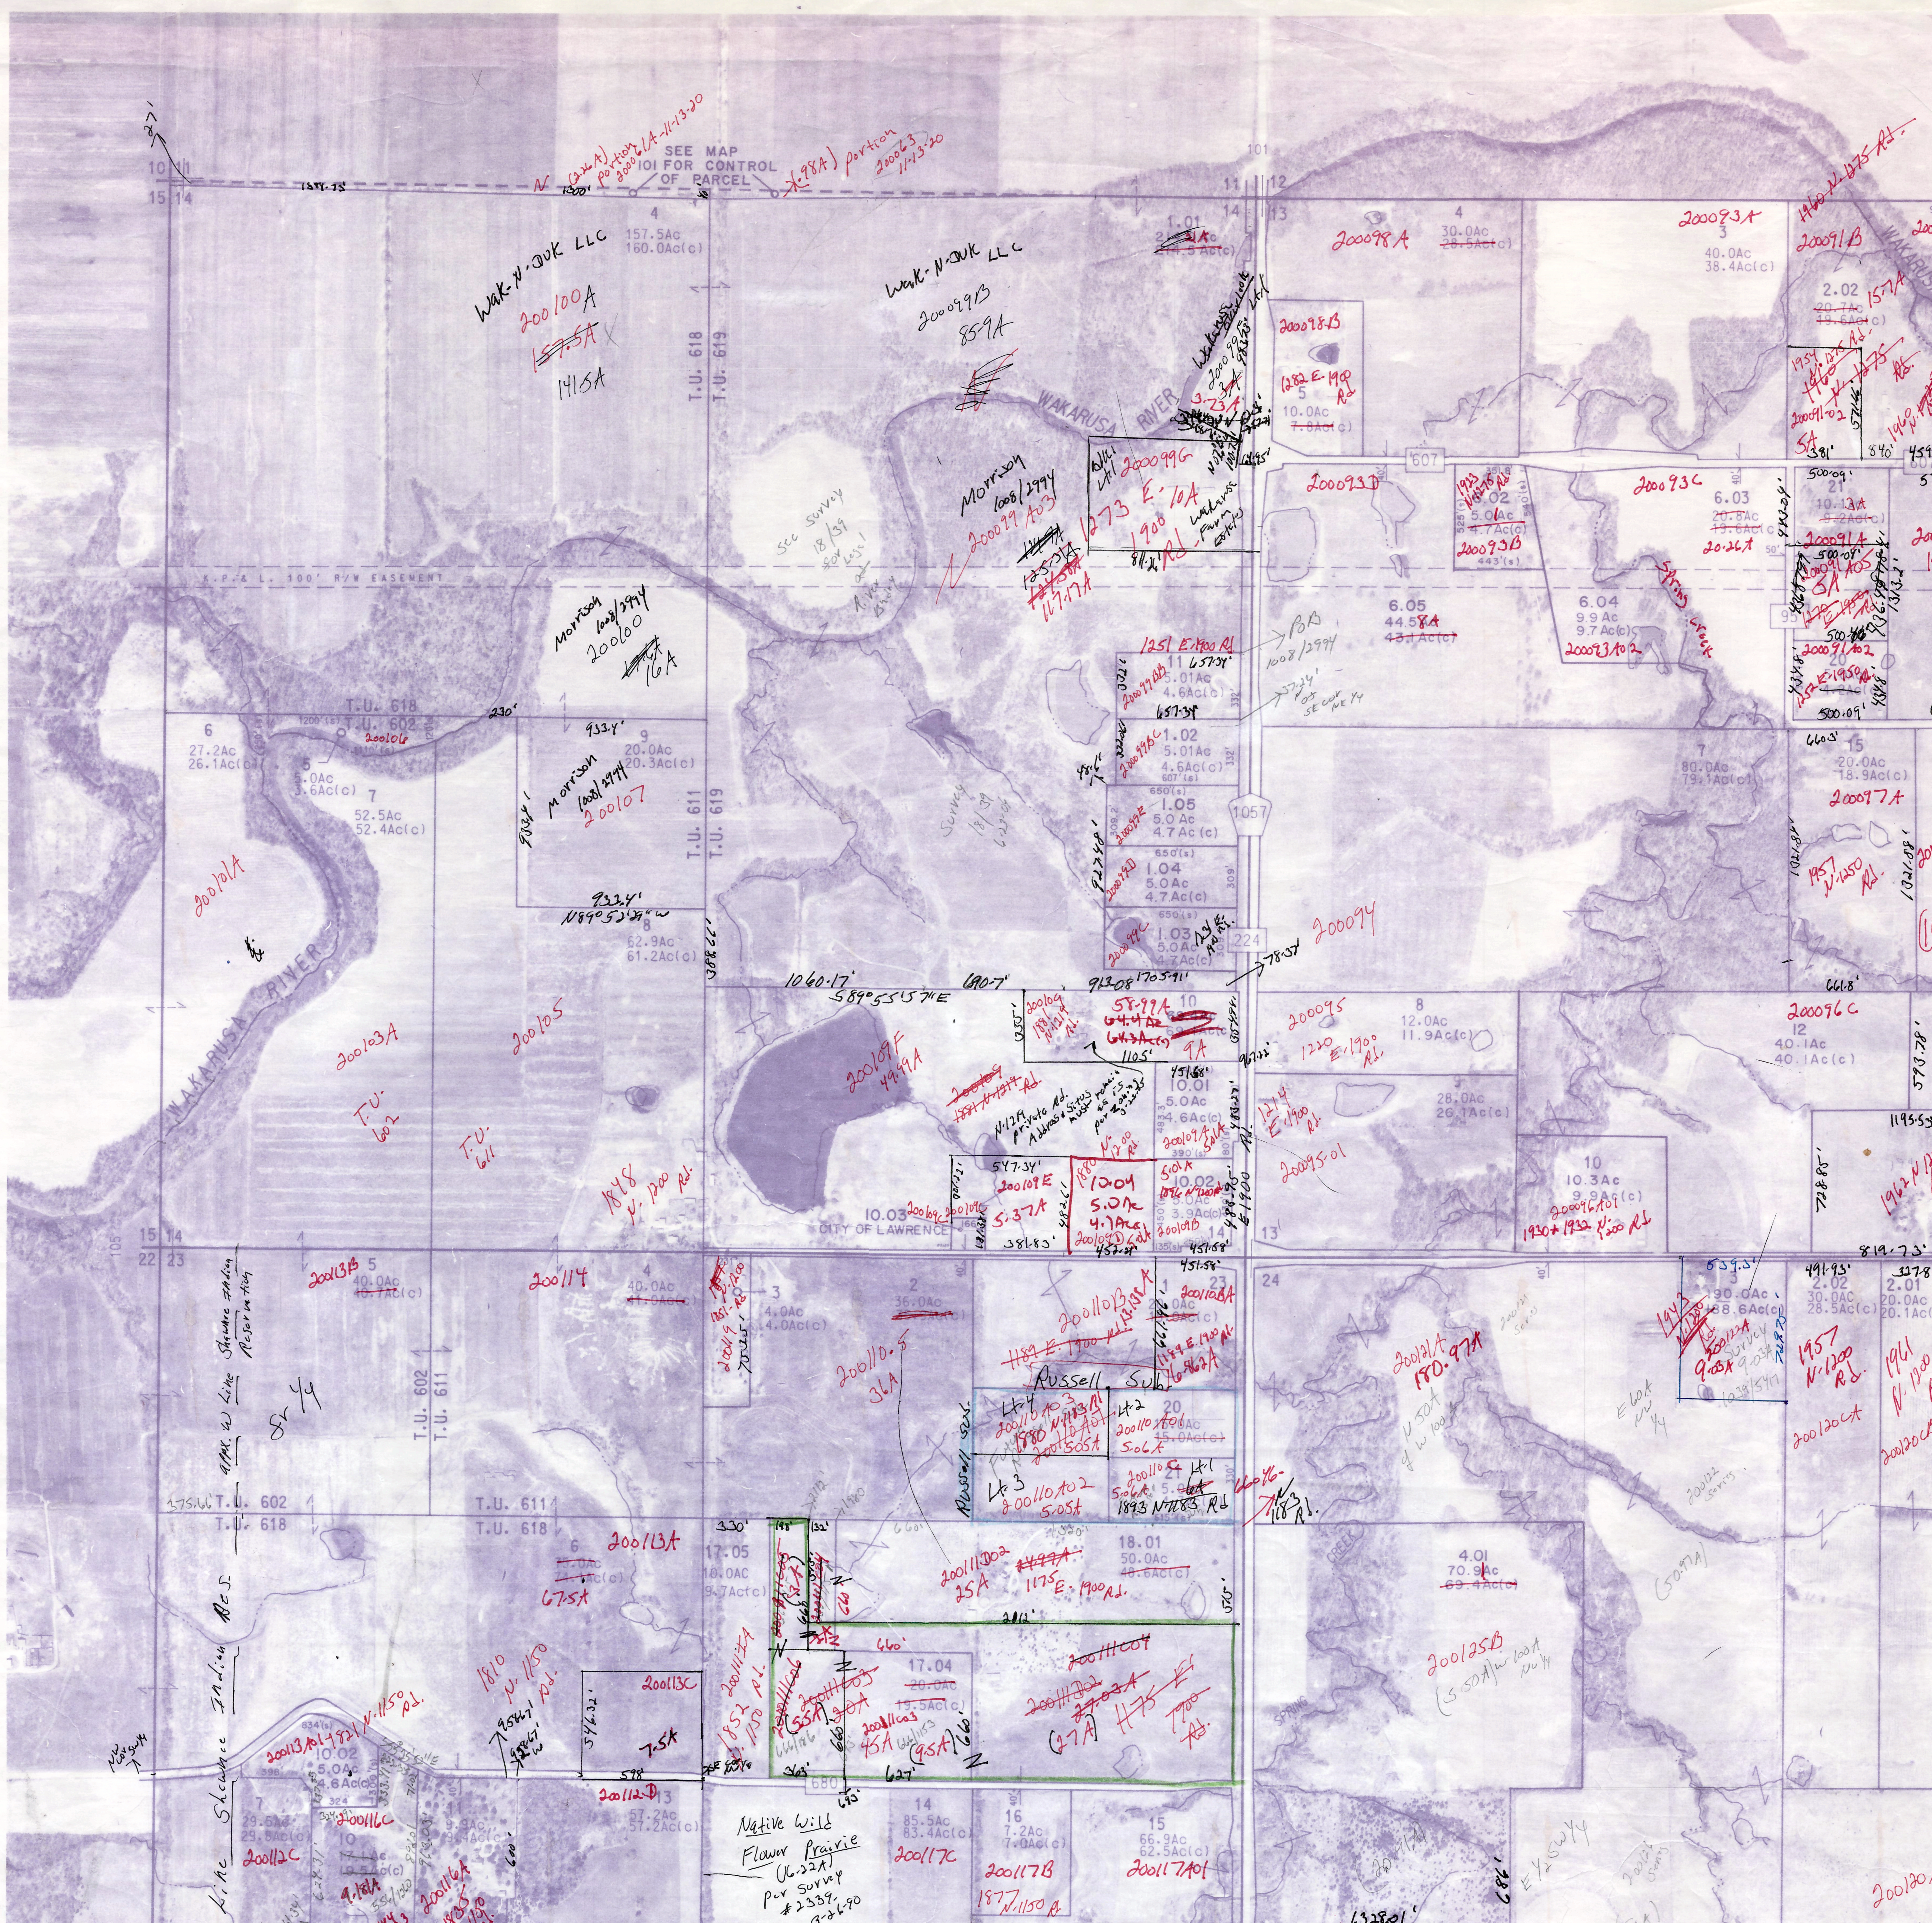

SEE MAP 101 FOR CONTROL OF PARCEL
N (2.26A) portion 200061A-11-13-20
(.98A) portion 200063 11-13-20
1354.73
10 11
15 14
11 12
14 13
12 7
13 18
4
157.5Ac
160.0Ac(c)
Wak-N-Duk LLC
200100A
~~157.5A~~
141.5A
Wak-N-Duk LLC
200099B
85.9A
T.U. 618
T.U. 619
K.P.& L. 100' R/W EASEMENT
WAKARUSA RIVER
Morrison 1008/2994 200100 16A
See Survey 18/39
Survey 18/39
Morrison 1008/2994 200099 A03
1273 E. 10A 1900 Rd.
~~125.31A~~
117.17A
Wakarusa Farm Estates
200099 3.73A
T.U. 618
T.U. 602
6
27.2Ac
26.1Ac(c)
200106
5
5.0Ac
3.6Ac(c)
7
52.5Ac
52.4Ac(c)
230'
9
20.0Ac
20.3Ac(c)
933.4'
Morrison 1008/2994 200107
933.4'
N89°52'27"W
8
62.9Ac
61.2Ac(c)
200101A
200103A
T.U. 602
200105
T.U. 611
T.U. 611
T.U. 619
1848 N. 1200 Rd.
1.01
~~24.5Ac(c)~~
101
5
200098A
4
30.0Ac
~~28.5Ac(c)~~
200098B
1282 E. 1900 Rd.
5
10.0Ac
~~7.8Ac(c)~~
607
200093D
1923 N. 1275 Rd.
6.02
5.01Ac
4.7Ac(c)
200093B
443'(s)
6.05
44.58A
~~43.1Ac(c)~~
6.04
9.9Ac
9.7Ac(c)
200093A02
200093C
6.03
~~20.8Ac~~
~~19.6Ac(c)~~
20.26A
Spring Creek
200093A
3
40.0Ac
38.4Ac(c)
1960 N. 1275 Rd.
200091B
200090
920'(s)
2.01
4.0Ac
9.6Ac(c)
2.02
~~20.7Ac~~
~~19.6Ac(c)~~
15.7A
1954 N. 1275 Rd.
200091A02
5A
381'
840'
459'
WAKARUSA RIVER
1 200080
18.0Ac
~~20.2Ac(c)~~
LITTLE WAKARUSA CREEK
22
61.4Ac
46.3Ac(c)
200091-01
Survey 982/5539
22.5A
Little Wakarusa Creek
200092
23
2.0Ac
4.1Ac(c)
21
10.1Ac
~~9.2Ac(c)~~
200091A
200091A05
574.8'
19
20.0Ac
~~19.0Ac(c)~~
200091A01
1961 N. 1275 Rd.
200091
38.93A
95
20
200091A02
E. 1950 Rd.
500.09'
699.1'
1441'
515.8'
200091A04
1980 N. 1250 Rd.
18
6.74A
4A
923.5'
17
12.0Ac
~~11.3Ac(c)~~
200091A03
1996 N. 1250 Rd.
564.7'
1251 E. 1900 Rd.
11
5.01Ac
4.6Ac(c)
200099BB
657.34'
POB 1008/2994
1.02
5.01Ac
4.6Ac(c)
200099BC
607'(s)
1.05
5.0Ac
4.7Ac(c)
200099E
1.04
5.0Ac
4.7Ac(c)
200099D
1.03
5.0Ac
4.7Ac(c)
200099C
1057
224
200094
121
7
80.0Ac
79.1Ac(c)
15
20.0Ac
18.9Ac(c)
200097A
1957 N. 1250 Rd.
Survey 983/3915
200096B03
20A
Survey 1006/271
(10A)
(10A)
661.8'
2042.24'
16
5.0Ac
~~4.4Ac(c)~~
200096B01
14
~~55.0Ac~~
~~55.2Ac(c)~~
200096B02
1235 E. 2000 Rd.
45A
43
1060.17'
S89°55'57"E
690.7'
913.08'
1705.91'
10
58.99A
~~64.4Ac~~
~~64.3Ac(c)~~
9A
200109 1881 N. 1214 Rd.
1105'
200109F
49.99A
~~200109 1881 N. 1214 Rd.~~
N. 1214 private Rd. Address & Status must remain as is per 06-03 3-22-25
10.01
5.0Ac
4.6Ac(c)
200109A
5.01A
1214 E. 1900 Rd.
547.34'
200109E
5.37A
1880 N. 1200 Rd.
10.04
5.0Ac
4.1Ac(c)
200109D
10.02
5.0Ac
3.9Ac(c)
200109B
1886 N. 1200 Rd.
10.03
CITY OF LAWRENCE
200109C
381.83'
452.34'
451.58'
E. 1900 Rd.
8
12.0Ac
11.9Ac(c)
200095
1220 E. 1900 Rd.
9
28.0Ac
26.1Ac(c)
200095.01
10
10.3Ac
9.9Ac(c)
200096A01
1930 & 1932 N. 1200 Rd.
12
40.1Ac
40.1Ac(c)
200096C
593.78'
12.02
40.1Ac
38.9Ac(c)
200096DB
12.01
20.0Ac
19.4Ac(c)
200096DA
1195.53'
713.2'
1962 N. 1200 Rd.
728.85'
13
10.0Ac
~~9.3Ac(c)~~
200096E
Survey 981/5664
1203 E. 200 Rd.
819.73'
674.55'
660'
15 14
22 23
Shawnee Indian Reservation
Appx. W Line
Sr 44
200113B
5
40.0Ac
~~40.1Ac(c)~~
200114
4
40.0Ac
~~41.0Ac(c)~~
1851 N. 1200 Rd.
3
4.0Ac
4.0Ac(c)
2
36.0Ac
200110.5
36A
1
20.0Ac
200110B
13.138A
200110BA
1189 E. 1900 Rd.
6.862A
Russell Sub.
Lt 4
200110A03
1880 N. 1183 Rd.
5.05A
Lt 2
20
15.0Ac(c)
200110A01
5.06A
Lt 3
200110A02
5.05A
21
Lt 1
200110C
5.06A
1893 N. 1183 Rd.
N. 1183 Rd.
24
200121A
180.97A
N 50A of W 100A
E 60A NW 1/4
3
190.0Ac
188.6Ac(c)
539.3'
1943 N. 1200 Rd.
200122A
9.03A
Survey 9.03A 1039/5417
2.02
30.0Ac
28.5Ac(c)
491.93'
1957 N. 1200 Rd.
200120CA
2.01
20.0Ac
20.1Ac(c)
327.8'
1961 N. 1200 Rd.
200120CB
250'
200120CC
5.01A
872.96'
200120CD
5.01A
200120B
~~104.44A~~
99.98A
1
110.0Ac
109.6Ac(c)
24 19
R-20E
R-21E
T.U. 602
T.U. 618
T.U. 611
T.U. 618
375.66'
6
~~74.1Ac(c)~~
200113A
67.5A
Appx W Line Shawnee Indian Res.
17.05
10.0Ac
9.7Ac(c)
200111A
1852 N. 1150 Rd.
330'
18.01
50.0Ac
~~48.6Ac(c)~~
200111D02
25A
1175 E. 1900 Rd.
17.04
20.0Ac
19.5Ac(c)
200111C03
45A
(9.5A)
200111C04
~~200111D02~~
~~27.03A~~
(27A)
1175 E. 1900 Rd.
660'
627'
680
4.01
70.9Ac
~~69.4Ac(c)~~
200125B
(5.50A) W 100A NW 1/4
(50.97A)
SPRING CREEK
1810 N. 1150 Rd.
200113C
7.5A
546.32'
598'
200112D
13
57.2Ac
57.2Ac(c)
200113A01
1821 N. 1150 Rd.
10.02
5.0Ac
4.6Ac(c)
7
29.5Ac
29.8Ac(c)
200112C
200116C
10
~~17.1Ac~~
~~19.54Ac(c)~~
9.18A
11
9.9Ac
9.4Ac(c)
200116A
1835 N. 1150 Rd.
1144 E. 1150 Rd.
200116CB
9.725A
1126 E. 1883 Rd.
200116CA
8.074A
1118 E. 1883 Rd.
Survey on 200116CA 200116CB
1807 N. 1150 Rd.
8.01
4.9Ac
8
12.0Ac(c)
200115A
5.1A
1804 N. 1100 Rd.
200115
5.876A
1808 N. 1100 Rd.
200115B
6.1A
1812 N. 1100 Rd.
225.18'
372.58'
968.77'
200116BA
9.01
10.1Ac
10.5Ac(c)
1824 N. 1100 Rd.
200116B
9
10.2Ac
10.5Ac(c)
1830 N. 1100 Rd.
22 23
27 26
500.28'
Native Wild Flower Prairie (16.22A) Per Survey #2339 3-26-90
14
85.5Ac
83.4Ac(c)
200117C
16
7.2Ac
7.0Ac(c)
200117B
1877 N. 1150 Rd.
15
66.9Ac
62.5Ac(c)
200117A01
E 1/2 SW 1/4
200121 Series
1328.01'
4.02
59.09Ac
55.9Ac(c)
200125A
1852 N. 1100 Rd.
1912 N. 1100 Rd.
180
23 24
26 25
5.01
146.5Ac
145.5Ac(c)
200120Ad
1123 E. 2000 Rd.
5.02
12.0Ac
11.5Ac(c)
200120A02
1958 N. 1100 Rd.
6
1.5Ac
1.2Ac(c)
200121-01
1103 E. 2000 Rd.
24 19
25 30

OWNERSHIP MAP
DOUGLAS COUNTY, KANSAS
PREPARED UNDER THE DIRECTION OF
KANSAS DEPARTMENT OF REVENUE
DIVISION OF PROPERTY VALUATION
AND
BOARD OF COMMISSIONERS
PREPARED BY
DOUGLAS COUNTY

REVISIONS DATE	BY	DATE	BY	DATE	BY	DATE	BY
8/..	DRA	3/26/91	DRA	8/04/92	DRA	2/08/93	SLT
4/5/90	DRA	8/22/91	DRA	8/24/92	DRA	3/08/93	[illegible]
1/17/91	DRA	2/05/92	DRA	2/16/92	SLT	2/27/94	DRA
1/29/91	DRA	3/23/92	DRA	1/15/93	SLT	8/17/94	DRA

SUBD NO.	SUBDIVISION NAME	PLAT BOOK	PLAT PAGE	SUBD CODE
	Russell sub. NENE 23-13-20			

THIS PROPERTY OWNERSHIP MAP IS FOR TAX PURPOSES ONLY
IS NOT INTENEDED FOR CONVEYANCES, NOR IS IT A LEGAL SURVEY

LEGEND

TOWNSHIP & RANGE
COUNTY LINE
CORPORATION LINE
TAXING UNIT LINE
R/W LINES
SECTION LINE
PROPERTY LINE
ORIGINAL LOT LINE
LAND HOOK
ORIGINAL BLOCK NO. (2)
ORIGINAL S/D LIMIT
MAP BLOCK NO. "03"
MAP BLOCK LIMIT WHERE APPLICABLE "03" "04"
AREA FROM DEED
AREA CALCULATED
DIMENSION FROM DEED
DIMENSION SCALED
SUBDIVISION LOT NUMBER
PARCEL NUMBER 10
WATER
INTERSTATE HIGHWAY
U.S. HIGHWAY
STATE
SECTION CORNERS

TOWNSHIP LOCATOR

MAP SHEET INDEX

1/4 SECTION INDEX

AUG 0 1 1996
8-1-96

SEC 13,14,23,24 TWP 13S RNG 20E

MAP NO. 106 DEC 15 1995 DEC 15 1995

SCALE 1"=400'
DATE OF MAP 11-88
DATE OF PHOTOGRAPHY 3-29-86
AERIAL PHOTO NO. 6-27
PARCEL COUNT 78

N