UAM UNITED AERIAL MAPPING 5411 JACKWOOD DRIVE · SAN ANTONIO, TEXAS 78238 · (512) 684 2147

DOUGLAS COUNTY, KANSAS   Date of photography: 3-27-86   Scale: 1"=100'   SW Sec. 10 , T 14 S , R 20 E   Exp. No. 36-05

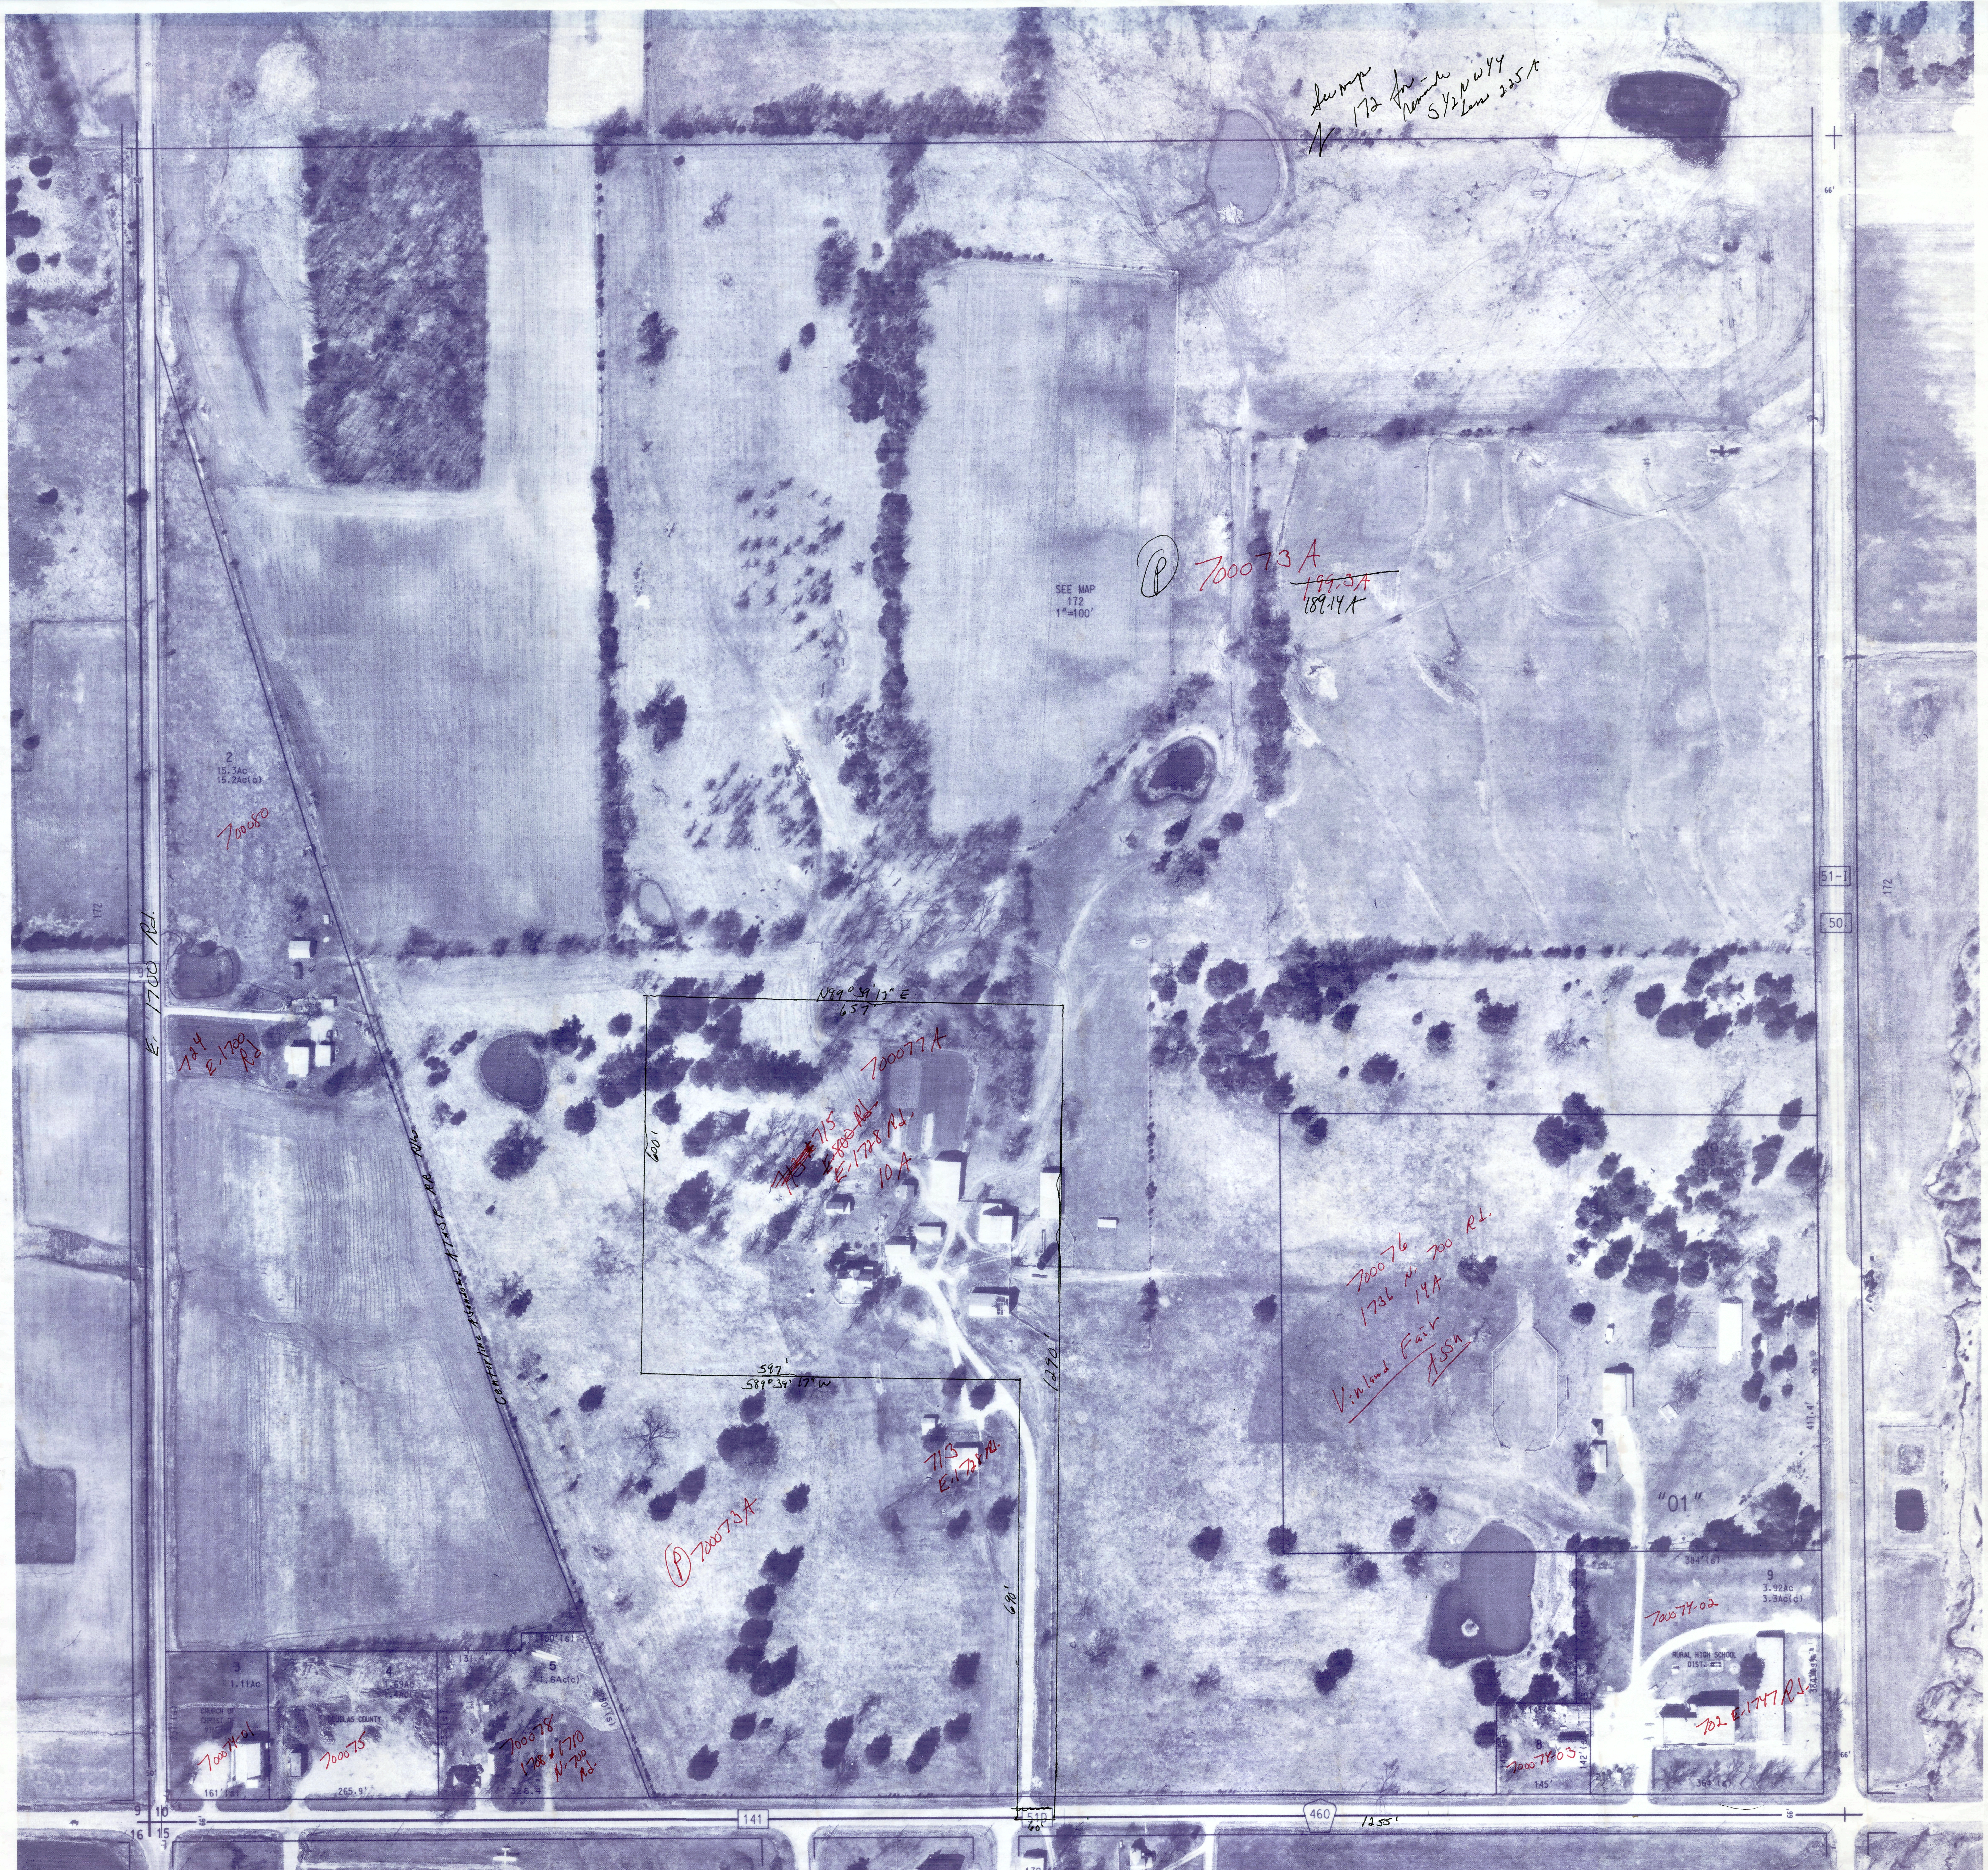
See map
172 for remainder
S½NW¼
Less 2.25A
50'
SEE MAP
172
1"=100'
Ⓟ 700073A
~~199.3A~~
189.14A
66'
2
15.3Ac
15.2Ac(c)
700080
172
E. 1700 Rd.
9
724
E.1700
Rd
51-1
50
172
Centerline Abandoned AT&SF RR R/W
N89°39'12" E
657'
700077A
~~715~~ 715
~~E 800 Rd.~~
E.1728 Rd.
10A
600'
597'
S89°39'17" W
1290'
10
13.8 Ac
13.4 Ac(c)
700076
1736 N. 700 Rd.
14A
Vinland Fair Assn
417.4'
"01"
713
E.1728 Rd.
Ⓟ 700073A
690'
384'(s)
9
3.92Ac
3.3Ac(c)
700074-02
RURAL HIGH SCHOOL
DIST. #1
702 E.1747 Rd.
241'(s)
20'
384'(s)
145'
8
142'(s)
142'(s)
700074-03
145'
364'(s)
66'
3
1.11Ac
CHURCH OF
CHRIST OF
VIN
211'(s)
700074-01
161'(s)
4
1.69Ac
1.4Ac(c)
DOUGLAS COUNTY
700075
265.9'
233'(s)
131.4'
100'(s)
5
1.6Ac(c)
280'(s)
700078
1708 & 1710
N. 700 Rd.
326.4'
9
10
16
15
66'
141
510
60'
460
1255'
66'
172-15-20

OWNERSHIP MAP
DOUGLAS COUNTY, KANSAS
PREPARED UNDER THE DIRECTION OF
KANSAS DEPARTMENT OF REVENUE
DIVISION OF PROPERTY VALUATION
AND
BOARD OF COMMISSIONERS
PREPARED BY
DOUGLAS COUNTY

REVISIONS DATE	BY	DATE	BY	DATE	BY	DATE	BY
3/21/90	SM						
3/09/93	SLT						
6/01/93	DRA						
2/6/94	SLT						

523295

SUBD NO	SUBDIVISION NAME	PLAT BOOK	PLAT PAGE	SUBD CODE

THIS PROPERTY OWNERSHIP MAP IS FOR TAX PURPOSES ONLY
IT IS NOT INTENEDED FOR CONVEYANCES, NOR IS IT A LEGAL SURVEY

LEGEND

TOWNSHIP & RANGE	▬▬▬	AREA FROM DEED	0.5 Ac (d)
COUNTY LINE	▬ ▬ ▬	AREA CALCULATED	10.5 Ac (c)
CORPORATION LINE	— — —	DIMENSION FROM DEED	16.5
TAXING UNIT LINE	- - -	DIMENSION SCALED	20'(s)
R/W LINES	═══	SUBDIVISION LOT NUMBER	23
SECTION LINE	━━━	PARCEL NUMBER	10
PROPERTY LINE	───	WATER	
ORIGINAL LOT LINE	┴┴┴	INTERSTATE HIGHWAY	70
LAND HOOK	┼	U.S. HIGHWAY	28
ORIGINAL BLOCK NO	(2)	STATE HIGHWAY	34
ORIGINAL S/D LIMIT	2|3	COUNTY ROAD	10
MAP BLOCK NO	"03"	TOWNSHIP ROAD	123
MAP BLOCK LIMIT (WHERE APPLICABLE)	"03" "04"	ROADS, STREETS, CHURCHES, ETC	BY NAME
		SECTION CORNERS	2 1 11 12

TOWNSHIP LOCATOR

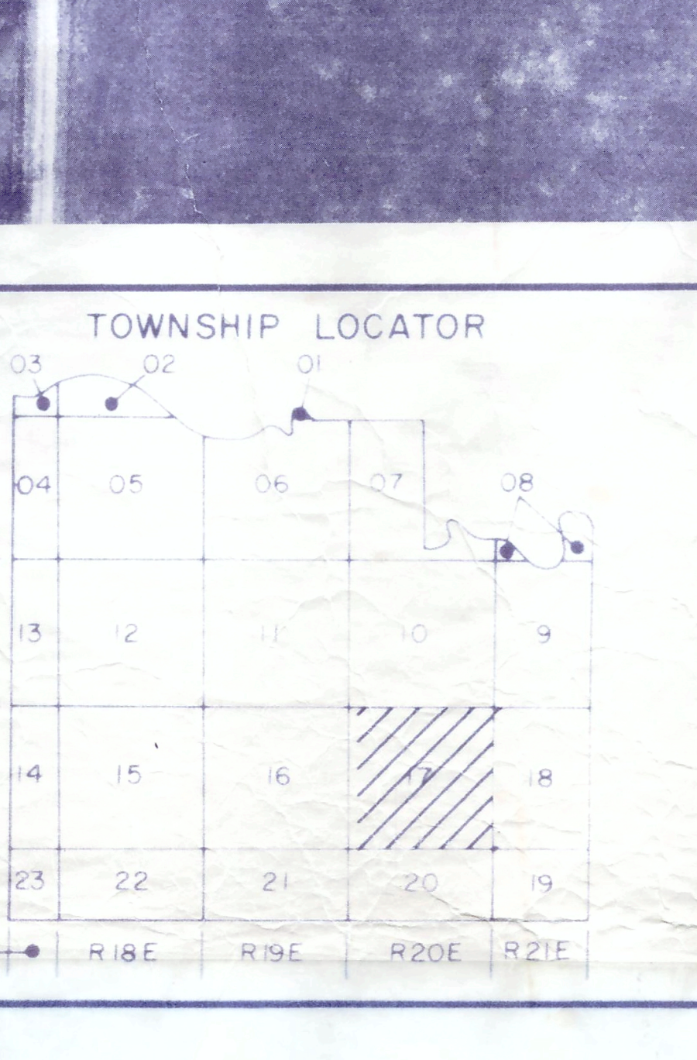
T11S
03
02
01
T12S
04
05
06
07
08
T13S
13
12
11
10
9
T14S
14
15
16
17
18
T15S
23
22
21
20
19
R17E
R18E
R19E
R20E
R21E

MAP SHEET INDEX

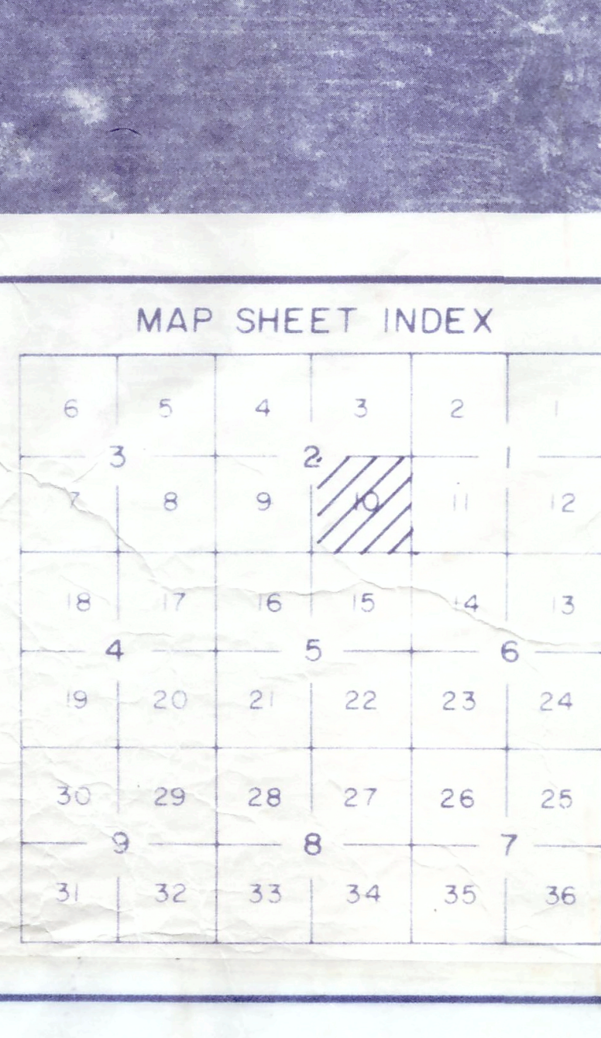
6
5
4
3
2
1
3
2
1
7
8
9
10
11
12
18
17
16
15
14
13
4
5
6
19
20
21
22
23
24
30
29
28
27
26
25
9
8
7
31
32
33
34
35
36

1/4 SECTION INDEX

jt
9.1.00

SEC. 10 TWP. 14S RNG. 20E

MAP NO. 172-10-30 MAY 30 1997

SCALE 1"=100
DATE OF MAP 12-88
DATE OF PHOTOGRAPHY 3-27-86
AERIAL PHOTO NO. 36-05
PARCEL COUNT 7

N

172-10-30