UNITED AERIAL MAPPING
5411 JACKWOOD DRIVE · SAN ANTONIO, TEXAS 78238 · (512) 684 2147

DOUGLAS COUNTY,KANSAS Date of photography: 3-27-86 Scale: 1"=100' NW Sec.15 , T14S , R20E Exp.No.36-07

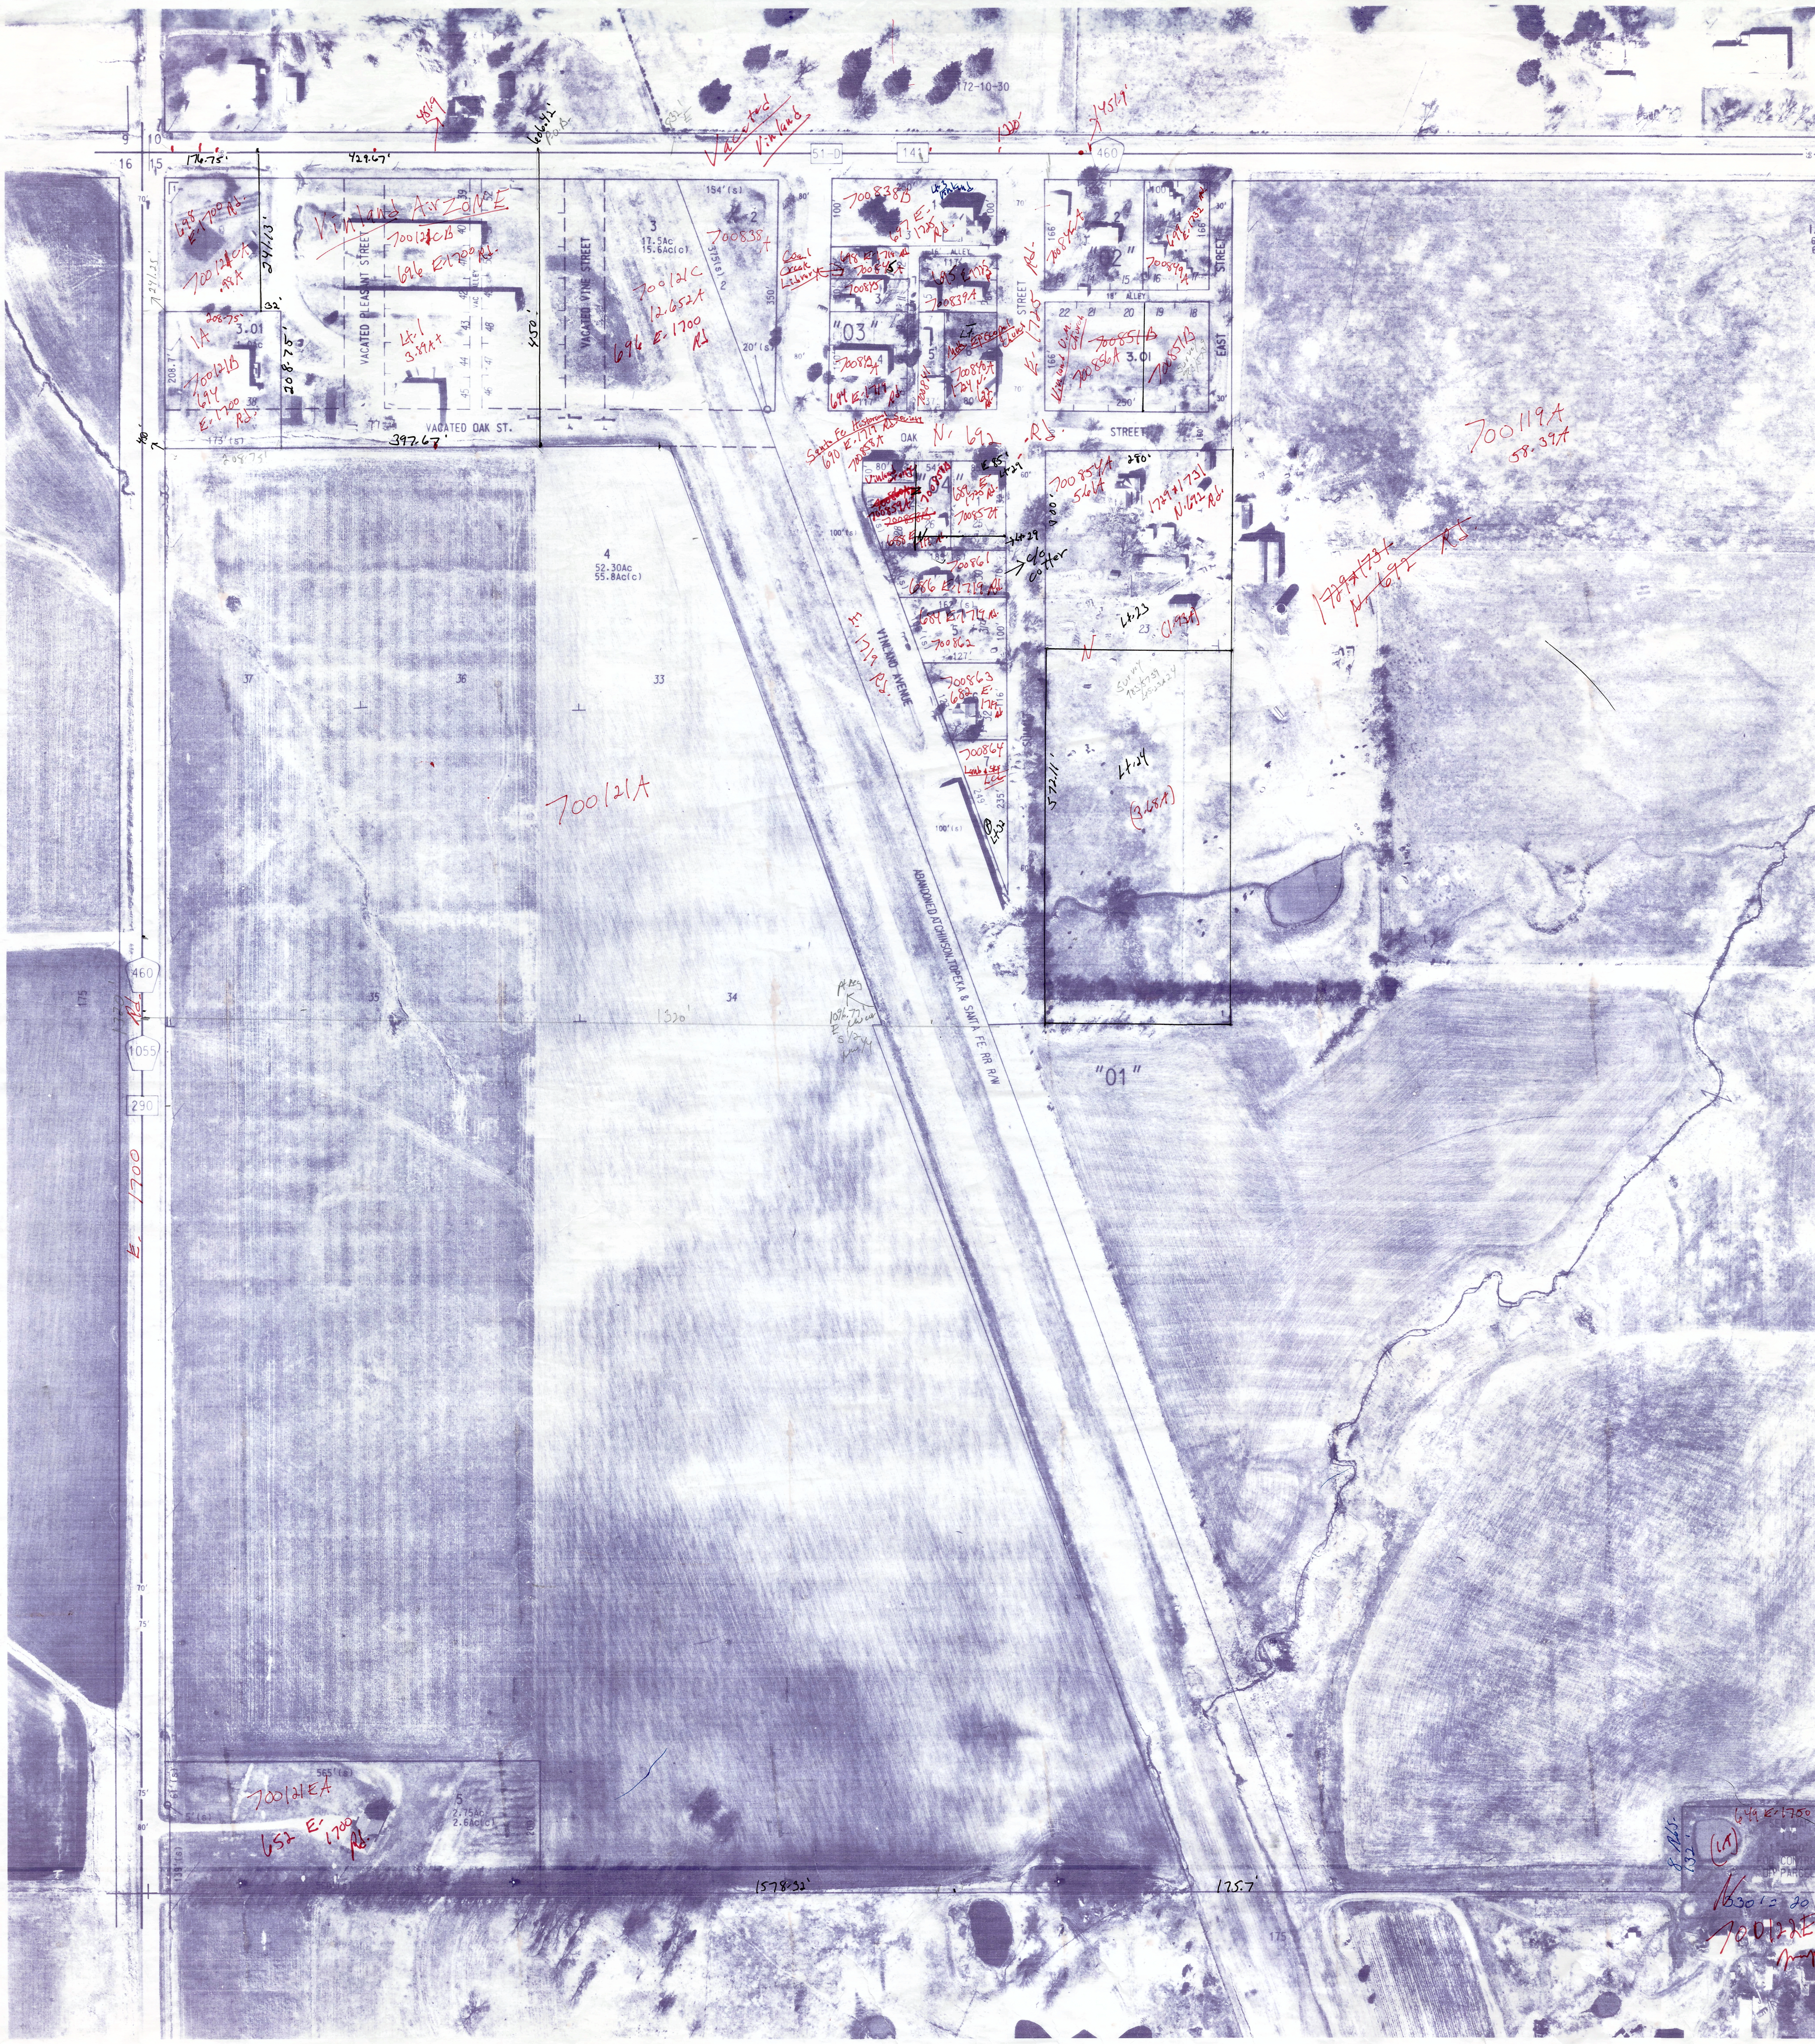
9
10
16
15
176.75'
429.67'
606.42' P.O.B.
481.9
Vacated Vinland
51-D
141
460
1320'
1451.9'
172-10-30
Vinland AirZONE
700121CB
696 E.1700 Rd.
698 E.1700 Rd.
700121CA .98A
241.13'
32'
1A
208.75'
3.01
700121B
694 E.1700 Rd.
208.7'
208.75'
38
173'(s)
397.67'
VACATED PLEASANT STREET
VACATED VINE STREET
VACATED OAK ST.
Lt.1 3.89A±
450'
3
17.5Ac
15.6Ac(c)
700121C
12.652A
696 E.1700 Rd.
2
154'(s)
700838A
375'(s)
350'
20'(s)
700838B
697 E. 1725 Rd.
Lt.3 Vinland
Coal Creek Library
698 E.1719 Rd.
700845A
700845
695 E.1725
700839A
"03"
700842A
694 E.1719 Rd.
Meth. Episcopal Church
700840A
1724 N. Rd.
ALLEY
STREET
E. 1725 Rd.
700849A
699 E.1732 Rd.
700849A
"02"
Vinland U.M. Church
700851B
700856A
3.01
700851B
EAST
STREET
Santa Fe Historical Society
690 E.1719 Rd.
700858A
OAK
N. 692 Rd.
Vinland Fair
"04"
700859A
700857A
688 E.
E 85'
Lt.29
700854A
5.61A
1729 + 1731 N.692 Rd.
280'
c/o Cotter
700861
686 E.1719 Rd.
684 E.1719 Rd.
700862
700863
682 E. 1719 Rd.
700864
Lamb & Kelly LLC
E. 1719 Rd.
VINLAND AVENUE
Lt.23
(1.93A)
N
Survey
Lt.24
(3.68A)
572.11'
Lt.22
ABANDONED ATCHINSON, TOPEKA & SANTA FE RR R/W
4
52.30Ac
55.8Ac(c)
700121A
37
36
33
35
34
1320'
1096.77'
700119A
58.39A
~~1729+1731 N.692 Rd.~~
1.01
64.0Ac
67.7Ac(c)
51-I
460
1055
290
E. 1700 Rd.
175
"01"
700121EA
652 E. 1700 Rd.
5
2.75Ac
2.6Ac(c)
565'(s)
1578.32'
175.7'
8 Rds. 132'
649 E.1750 Rd.
(LT)
~~700120A~~
330' = 20 Rds.
700122E
Map 175

OWNERSHIP MAP
DOUGLAS COUNTY, KANSAS
PREPARED UNDER THE DIRECTION OF
KANSAS DEPARTMENT OF REVENUE
DIVISION OF PROPERTY VALUATION
AND
BOARD OF COMMISSIONERS
PREPARED BY
DOUGLAS COUNTY

REVISIONS	DATE	BY	DATE	BY	DATE	BY	DATE	BY
	7/07/89	SRM						

SUBD NO.	SUBDIVISION NAME	PLAT BOOK	PLAT PAGE	SUBD CODE
1	VINLAND	2	15	2060

THIS PROPERTY OWNERSHIP MAP IS FOR TAX PURPOSES ONLY
IT IS NOT INTENEDED FOR CONVEYANCES, NOR IS IT A LEGAL SURVEY

LEGEND

TOWNSHIP & RANGE	▬	AREA FROM DEED	
COUNTY LINE	▬ ▬	AREA CALCULATED	
CORPORATION LINE	▬ — ▬	DIMENSION FROM DEED	
TAXING UNIT LINE	— — —	DIMENSION SCALE	
R/W LINES	═	SUBDIVISION LOT NUMBER	
SECTION LINE	▬	PARCEL NUMBER	10
PROPERTY LINE	—	WATER	
ORIGINAL LOT LINE	—	INTERSTATE HIGHWAY	70
LAND HOOK		U.S. HIGHWAY	28
ORIGINAL BLOCK NO	(2)	STATE HIGHWAY	34
ORIGINAL S/D LIMIT		COUNTY ROAD	
MAP BLOCK NO	"03"	TOWNSHIP ROAD	23
MAP BLOCK LIMIT WHERE APPLICABLE	"03" "04"	ROADS, STREETS, CHURCHES, ETC.	BY NAME
		SECTION CORNERS	2 1 / 11 12

TOWNSHIP LOCATOR

MAP SHEET INDEX

1/4 SECTION INDEX

JUN 17 1996

SEC 15 TWP 14S RNG 20E

MAP NO 175-15-20

SEP 15 1995

SCALE	1"=100
DATE OF MAP	12-88
DATE OF PHOTOGRAPHY	3-27-86
AERIAL PHOTO NO	36-07
PARCEL COUNT	23

175-15-20