UNITED AERIAL MAPPING
5411 JACKWOOD DRIVE · SAN ANTONIO, TEXAS 78238 · (512) 684-2?4

DOUGLAS COUNTY, KANSAS Date of photography: 3-29-86 Scale: 1" = 400' T 14 S , R 21 E Exp.No. 9-35

16|15
21|22

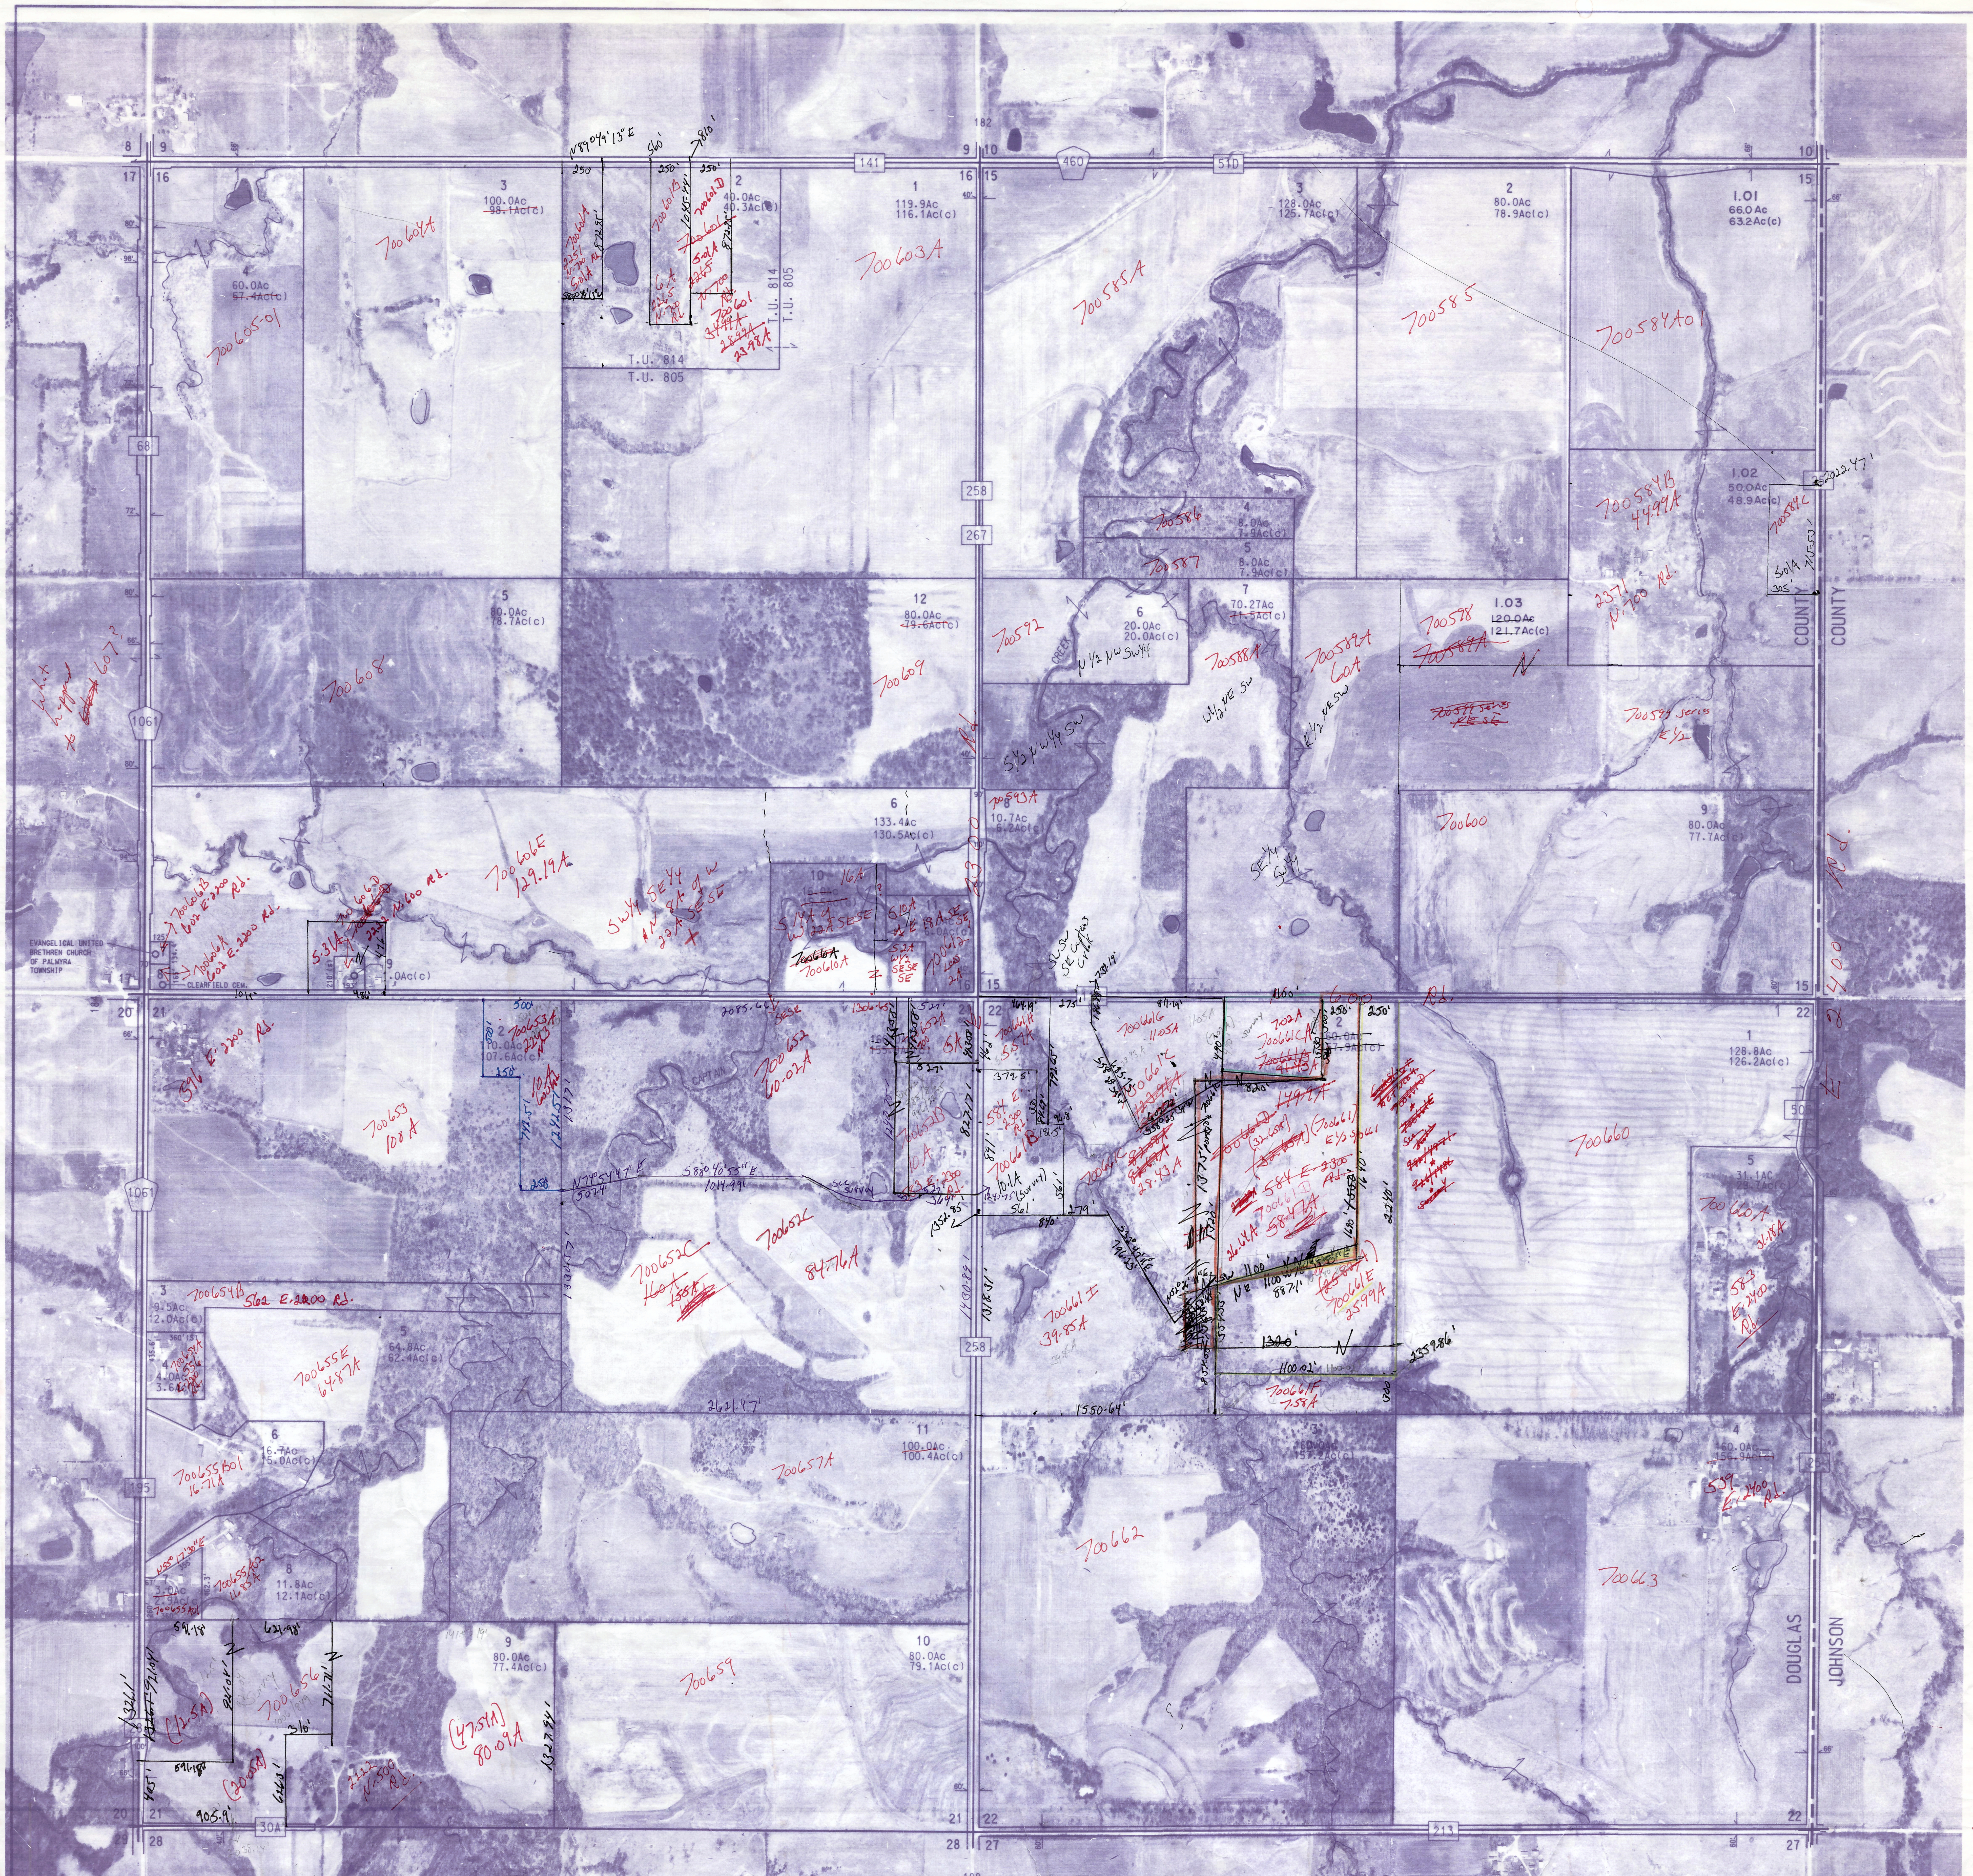

8 9 17 16
3
100.0Ac
~~98.1Ac(c)~~
700604A
4
60.0Ac
~~57.4Ac(c)~~
700605-01
N89°04'13"E
250' 560' 250' 250' 810'
2
40.0Ac
40.3Ac(c)
700601A 2251 N.700 Rd. 5.01A
872.25'
700601B 6A 2265 N.700 Rd.
1085.44'
700601D
~~700601~~ 5.01A 2265 N.700 Rd.
700601
~~37.99A~~
~~28.99A~~
23.98A
S89°04'13"W
T.U. 814
T.U. 805
141
1
119.9Ac
116.1Ac(c)
700603A
9 10 16 15
182
460
51D
258
267
68
1061
195
700585A
3
128.0Ac
125.7Ac(c)
2
80.0Ac
78.9Ac(c)
700585
700584A01
1.01
66.0Ac
63.2Ac(c)
10 15
1.02
50.0Ac
48.9Ac(c)
700584B
44.99A
700584C
5.01A
305'
1553'
2022.47'
2371 N.700 Rd.
COUNTY
COUNTY
4
8.0Ac
7.9Ac(c)
700586
5
8.0Ac
7.9Ac(c)
700587
6
20.0Ac
20.0Ac(c)
N1/2 NW SW1/4
CREEK
700592
7
70.27Ac
~~71.5Ac(c)~~
700588A
W1/2 NE SW
700589A
60A
E1/2 NE SW
1.03
~~120.0Ac~~
121.7Ac(c)
700598
~~700589A~~
N
~~700599 series NE SE~~
700599 series E1/2
S1/2 N W1/4 SW
SE1/4 SW1/4
9
80.0Ac
77.7Ac(c)
700600
400 Rd.
E 2
5
80.0Ac
78.7Ac(c)
700608
What happened to ~~607~~ 607?
12
80.0Ac
~~79.6Ac(c)~~
700609
Rd.
2300
8
10.7Ac
6.2Ac(c)
700593A
6
133.4Ac
130.5Ac(c)
700606E
129.19A
SW1/4 SE1/4 AN 8A of W 22A SESE
10
16.0Ac
16A
S1/4A of W 22A SESE
5.10A of E 18A SE
11
6.0Ac(c)
~~700610A~~
700610A
5.2A W1/2 SESE SE
700612 Less 2A
SWSW SE Captains Creek
700606B 602 E.2200 Rd.
700606A 602 E.2200 Rd.
700606D 2222 N.600 Rd.
5.31A
EVANGELICAL UNITED BRETHREN CHURCH OF PALMYRA TOWNSHIP
CLEARFIELD CEM.
125' 134.4' 70' 165'
210'(s) 193' 486' 476' 1015'
9
.0Ac(c)
80' 98' 77' 72' 80' 66' 80' 94' 66' 40' 90'
20 21 22
596 E.2200 Rd.
2
10.0Ac
107.6Ac(c)
500' 500'
700653A 2243 N.?
10A Court
250'
742.51'
1242.57'
1317'
258
N74°54'47"E 502.4'
S88°40'55"E 1014.99'
Sec Survey
700653
108A
2085.66' SESE
700652
60.02A
CAPTAIN
1306.65'
521'
700652A 6A
700652B 10A
583 E.2300 Rd.
827'
827.17'
1430.89'
1318.31'
1330.57'
352.85'
464.19'
700661H 5.57A
379.5'
584 E.2300 Rd.
700661B 10.1A
1240.75' (Survey)
561'
840'
279'
792.65'
181.5'
700661G 11.05A
700661E ~~12.94A~~
700661C ~~81.08A~~ 28.43A
844.19'
275'
1160'
7.02A
700661CA
~~700661A~~ ~~41.43A~~
~~149.9A~~
~~700661D~~ (32.65A) (700661) E1/2 S 661
584 E.2300 Rd.
700661D
~~58.47A~~
26.64A
1375'
1680'
1640'
2240'
NE 1100'
887.1'
700661E
25.99A
1320'
1100.02'
2359.86'
700661F
7.58A
700661I
39.85A
S 52°41' E 796.23'
N52°26'E
250' 250'
2
60.0Ac
57.9Ac(c)
1
128.8Ac
126.2Ac(c)
22
505
700660
5
31.1AC
29.7Ac(c)
700660A
31.18A
583 E.2400 Rd.
700652C
160A
~~155A~~
700652C
84.76A
2621.47'
1550.64'
3
9.5Ac
12.0Ac(c)
700654B
562 E.2200 Rd.
4
4.0Ac
3.6Ac(c)
700654A 556 E.2200 Rd.
360'(s) 135.6'
700655E
64.87A
5
64.8Ac
62.4Ac(c)
6
16.7Ac
15.0Ac(c)
700655B01
16.71A
7
3.0Ac
2.9Ac(c)
N55°17'30"E
355' 67' 462.3' 260' 360'
700655A01
700655A02
11.85A
8
11.8Ac
12.1Ac(c)
591.18'
621.98'
921.04'
1322.61'
(12.5A)
700656
(20.05A)
711.71'
316'
626.31'
905.9'
405'
2222 N.500 Rd.
30A
20 21 29 28
9
80.0Ac
77.4Ac(c)
(47.54A)
80.09A
1327.94'
11
100.0Ac
100.4Ac(c)
700657A
700662
3
160.0Ac
157.2Ac(c)
4
160.0Ac
156.9Ac(c)
539 E.2400 Rd.
700663
10
80.0Ac
79.1Ac(c)
700659
21 22 28 27
188
213
22 27
DOUGLAS
JOHNSON
60' 66'

OWNERSHIP MAP
DOUGLAS COUNTY, KANSAS
PREPARED UNDER THE DIRECTION OF
KANSAS DEPARTMENT OF REVENUE
DIVISION OF PROPERTY VALUATION
AND
BOARD OF COMMISSIONERS
PREPARED BY
DOUGLAS COUNTY

REVISIONS DATE	BY	DATE	BY	DATE	BY	DATE	BY
7/07/89	DRA						
8/2/90	DRA						

SUBD NO.	SUBDIVISION NAME	PLAT BOOK	PLAT PAGE	SUBD CODE

THIS PROPERTY OWNERSHIP MAP IS FOR TAX PURPOSES ONLY
IT IS NOT INTENEDED FOR CONVEYANCES, NOR IS IT A LEGAL SURVEY

LEGEND

TOWNSHIP & RANGE		AREA FROM DEED	10.5 Ac(d)
COUNTY LINE		AREA CALCULATED	10.5 Ac(c)
CORPORATION LINE		DIMENSION FROM DEED	165
TAXING UNIT LINE		DIMENSION SCALED	20'(s)
R/W LINE		SUBDIVISION LOT NUMBER	23
SECTION LINE		PARCEL NUMBER	10
PROPERTY LINE		WATER	
ORIGINAL LOT LINE		INTERSTATE HIGHWAY	70
LAND HOOK		U.S. HIGHWAY	28
ORIGINAL BLOCK NO.	(2)	STATE HIGHWAY	34
ORIGINAL S. DECIMAL		COUNTY ROAD	16
MAP BLOCK NO.	"03"	TOWNSHIP ROAD	23
MAP BLOCK LIMIT WHERE APPLICABLE	"03" "04"	ROADS, STREETS, CHURCHES, ETC.	BY NAME
		SECTION CORNERS	2 1 / 11 12

TOWNSHIP LOCATOR

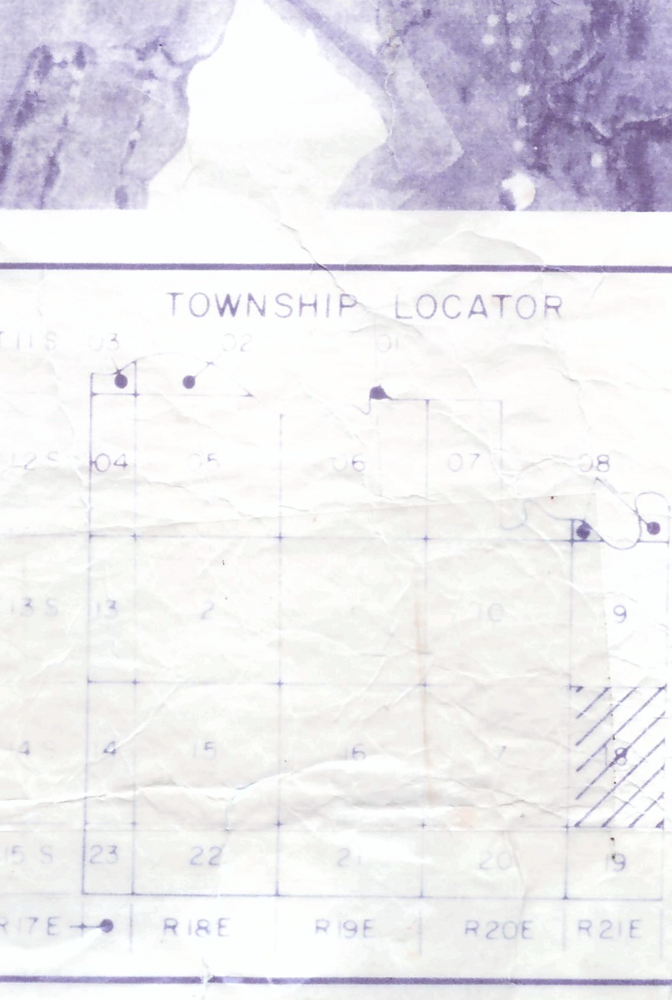

T11S 03 02 01
T12S 04 05 06 07 08
T13S 13 2 10 9
T14S 14 15 16 17 18
T15S 23 22 21 20 19
R17E R18E R19E R20E R21E

MAP SHEET INDEX

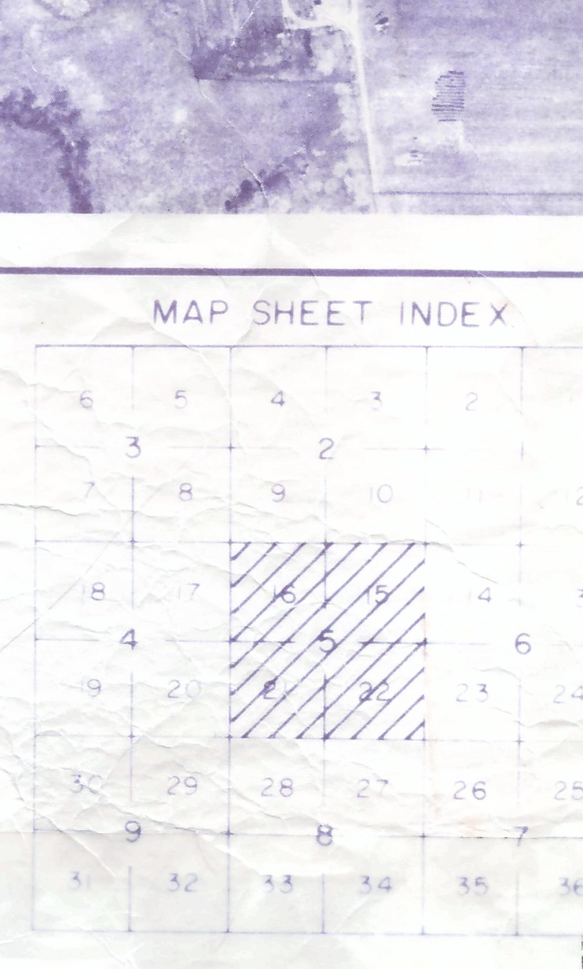

6 5 4 3 2
3 2
7 8 9 10 11 12
18 17 16 15 14 13
4 5 6
19 20 21 22 23 24
30 29 28 27 26 25
9 8 7
31 32 33 34 35 36

1/4 SECTION INDEX

20	10
30	40

JUL 18 1997

SEC 15,16,21,22 TWP 14S RNG 21E

MAP NO. 185 JUL 21 1995

SCALE 1"=400'
DATE OF MAP 11-88
DATE OF PHOTOGRAPHY 3-29-86
AERIAL PHOTO NO. 9-35
PARCEL COUNT 36

185