DOUGLAS COUNTY, KANSAS   Date of photography: 3-29-86   Scale: 1" = 400'   18|17 / 19|20   T 15 S , R 20 E   Exp. No. 12-22

UNITED AERIAL MAPPING
5411 JACKWOOD DRIVE · SAN ANTONIO TEXAS 78238 · (512) 684-

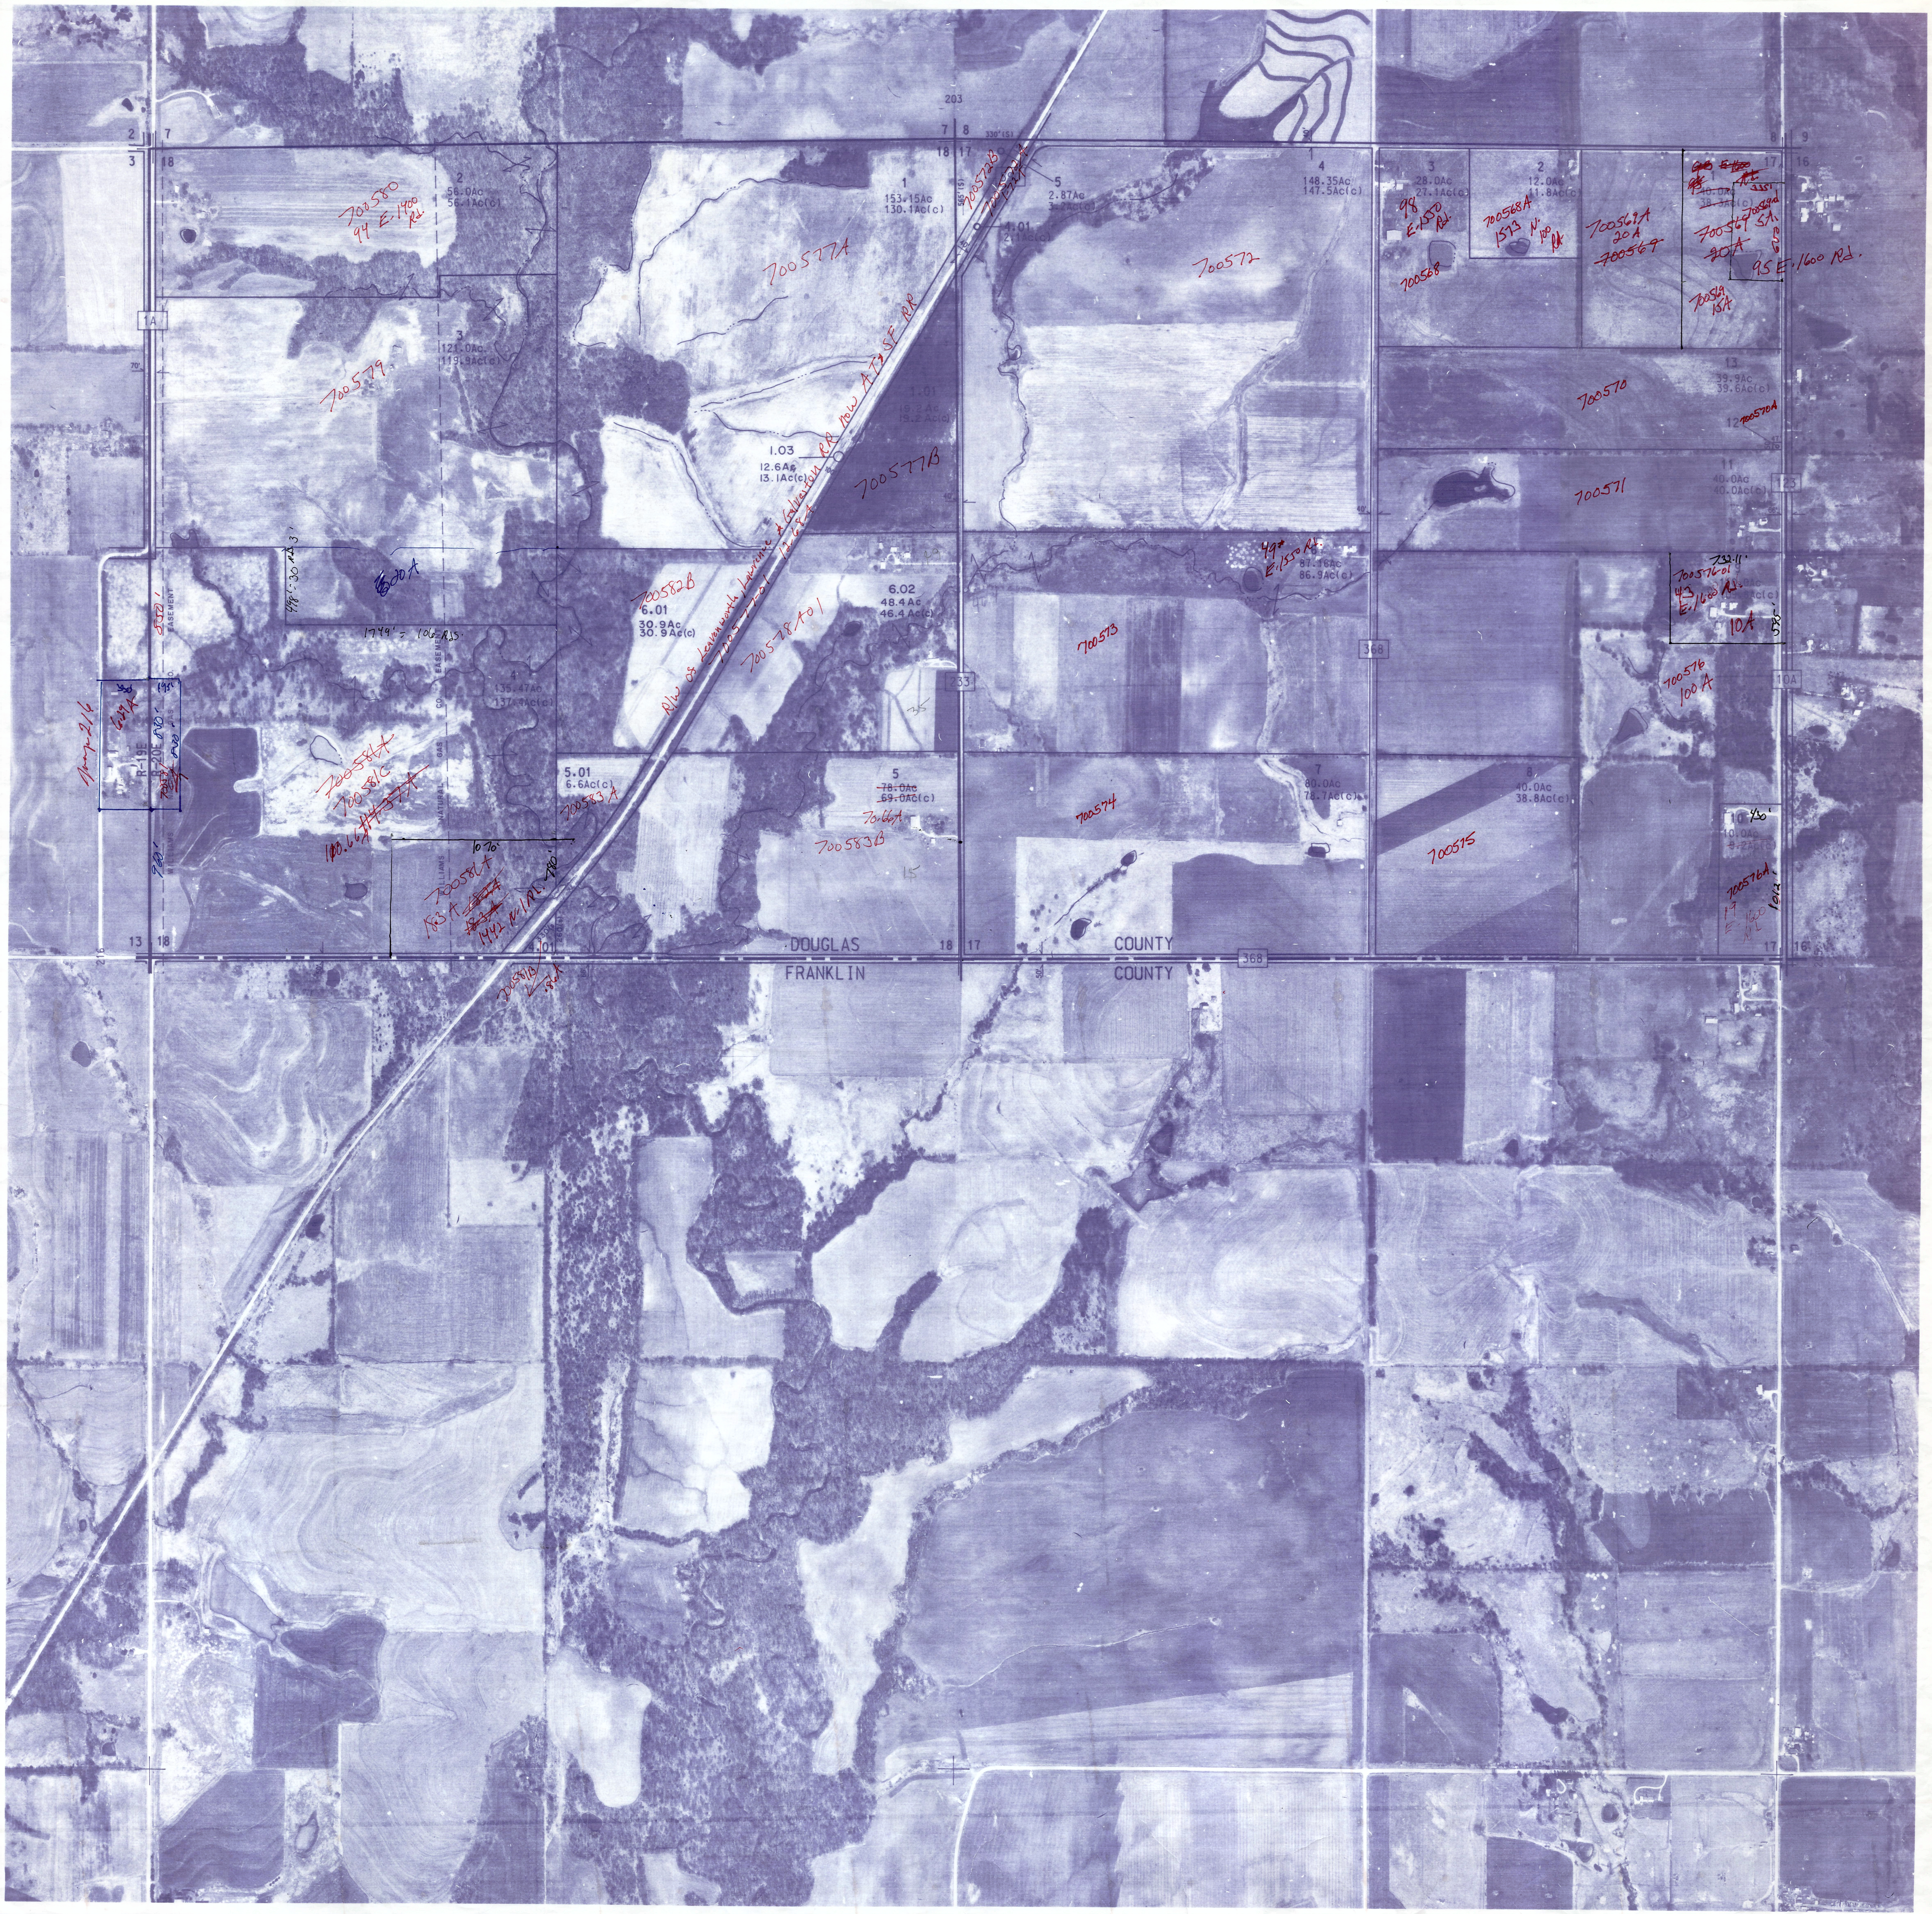

2
7
3
18
203
7 8
18 17
8 9
17 16
330'(S)
565'(S)
1A
70'
2
56.0Ac
56.1Ac(c)
700580
94 E. 1400 Rd.
3
121.0Ac
119.9Ac(c)
700579
1
153.15Ac
130.1Ac(c)
700577A
700572B
700572A
1.72A
5
2.87Ac
3.2Ac(c)
4.01
2.1Ac(c)
4
148.35Ac
147.5Ac(c)
700572
3
28.0Ac
27.1Ac(c)
98 E. 1550 Rd.
700568
2
12.0Ac
11.8Ac(c)
700568A
1573 N. 100 Rd.
700569A
20A
~~700569~~
1
40.0Ac
38.3Ac(c)
331'
700569d
5A
~~20A~~
650'
95 E. 1600 Rd.
700569
15A
13
39.9Ac
39.6Ac(c)
700570
12 700570A
47'
11
40.0Ac
40.0Ac(c)
700571
123
66'
1.01
19.2Ac
19.2Ac(c)
1.03
12.6Ac
13.1Ac(c)
700577B
R/W of Leavenworth, Lawrence & Galveston RR now AT & SF RR
700577-01
12.68A
40'
498' = 30 Rds 3'
6.20A
1749' = 106 Rds.
EASEMENT
WILLIAMS NATURAL GAS CO. EASEMENT
700582B
6.01
30.9Ac
30.9Ac(c)
700578A01
6.02
48.4Ac
46.4Ac(c)
233
35
4
135.47Ac
137.4Ac(c)
49# E. 1550 Rd.
6
87.16Ac
86.9Ac(c)
700573
368
732.11'
700576-01
43 E. 1600 Rd.
9
10A
585'
700576
100A
10A
Range 21 6
6.29A
330'
195'
R-19E
R-20E
850'
700581
700581A
700581C
~~700577A~~
100.66A
960'
5.01
6.6Ac(c)
700583A
1070'
700581A
183A
~~183A~~
1442 N. 1 Rd.
780'
5
~~78.0Ac~~
69.0Ac(c)
70.66A
700583B
15
7
80.0Ac
78.7Ac(c)
700574
8
40.0Ac
38.8Ac(c)
700575
10
10.0Ac
~~9.2Ac(c)~~
430'
700576A
19 E. 1600 Rd.
1012'
13 18
18 17
17 16
216
4.01
DOUGLAS COUNTY
FRANKLIN COUNTY
700581B
.86A
50'
368

OWNERSHIP MAP
DOUGLAS COUNTY, KANSAS
PREPARED UNDER THE DIRECTION OF
KANSAS DEPARTMENT OF REVENUE
DIVISION OF PROPERTY VALUATION

BOARD OF COMMISSIONERS
PREPARED BY
DOUGLAS COUNTY

REVISIONS DATE	BY	DATE	BY	DATE	BY	DATE	BY

SUBD. NO.	SUBDIVISION NAME	PLAT BOOK	PLAT PAGE	SUBD. CODE

THIS PROPERTY OWNERSHIP MAP IS FOR TAX PURPOSES ONLY. IS NOT INTENDED FOR CONVEYANCES, NOR IS IT A LEGAL SURVEY.

LEGEND

TOWNSHIP & RANGE		AREA FROM DEED	
COUNTY LINE		AREA CALCULATED	
CORPORATION LINE		DIMENSION FROM DEED	
TAXING UNIT LINE		DIMENSION SCALED	
R/W LINE		SUBDIVISION NUMBER	
SECTION LINE		PARCEL NUMBER	10
PROPERTY LINE		WATER	
ORIGINAL LOT LINE		INTERSTATE HIGHWAY	70
LAND HOOK		U.S. HIGHWAY	28
ORIGINAL BLOCK NO.	②	STATE HIGHWAY	34
ORIGINAL S.D. LIMIT	⊥	COUNTY ROAD	10
MAP BLOCK NO.	"03"	TOWNSHIP ROAD	123
		ROADS, STREETS, BY NAME	
MAP BLOCK NUMBER WHERE APPLICABLE	"03" "04"	SECTION CORNERS	2 1 / 11 12

TOWNSHIP LOCATOR

MAP SHEET INDEX

3	2	1			
18	17	6	5	4	3
19	20	2	22	23	24
30	29	28	27	26	25
9		8		7	
	33	34	35		36

1/4 SECTION INDEX

20	10
30	40

5-7-01
jt

SEC 17,18 TWP 15S RNG 20E

MAP NO. 204

JUL 21 1995

SCALE 1"=400
DATE OF MAP 11-88
DATE OF PHOTOGRAPHY 3-29-86
AERIAL PHOTO NO. 12-22
PARCEL COUNT 26

N

204